MISSISSIPPI DEPARTMENT OF NATURAL RESOURCES

Bureau of Land and Water Resources

P.O. Box 10631
Jackson, Mississippi 39209

WATER WELL DRILLERS LOG

COUNTY WELL LOCATED: Pike	
WELL NUMBER: 298807	CODED:
L2100	
DATE WELL COMPLETED: 5/31/95	

PERMIT NUMBER: 510	
NAME OF DRILLING FIRM: Easley Water Wells	
Brookhaven, MS 39601	

NAME & MAILING ADDRESS OF LANDOWNER: Dorothy Lane

WELL LOCATION: SEC 32 TOWNSHIP 1 (N) S RANGE 8 (E) W

DISTANCE _____ Miles DIRECTION _____ of NEAREST TOWN _____

OTHER LANDMARK

WELL PURPOSE: Home, Irrigation, Municipal, Industrial, Fish Pond, etc.

PUMP DATA

PUMP TYPE (Circle One): Submersible, Turbine, Jet Flowing Well, Other (Describe) 1 HP

POWER TYPE (Circle One): Electric, Tractor, Diesel, Gasoline, Butane, Other (Describe)

Pump Capacity (GPM)	No. of Stages	Setting Depth
10	15	FT.

PUMP TEST

Well yielded _____ GPM with a drawdown of _____ ft. after _____ hours of pumping

WELL DATA

Well Depth	Casing Diameter (In.)	Casing Length (Ft.)
300'	4"	280

Type of Casing	Hole Depth	Depth to Static Water Level
PVC	300	

TYPE OF COMPLETION: (Circle One or More): Gravel Packed, Underreamed, Telescoped, Natural Development, Open Hole, Other (Describe)

Top of Lap Pipe or Reduction in Casing FEET

IF TELESCOPED OR MORE THAN ONE SCREEN: USE BACK PAGE

SCREEN DATA

Diameter - Inches	Length - Feet	Slot Size - Inches
4"	20	18

Screen Type	Depth to Bottom - Feet
PVC	300

LOG DATA

TYPE OF LOG RUN (Circle One): No Log Run, Electric, Gamma Ray, Density, Sonic, Neutron, Other (Describe)

Name of Organization Running Log

GEOLOGIC DATA (Office Use Only)

Surface Elev.	Geologic Unit	Unit Thickness	Depth to Top
Sub SWL	Date	Analysis	Aquifer Test

RECEIVED AUG 30 1995 Dept. of Environmental Quality Office of Land & Water Resources

Driller's Remarks

DESCRIPTION OF FORMATIONS ENCOUNTERED	FROM	TO	FORMATIONS (Continued)	FROM	TO
Clay	0	20			
Gravel	20	90			
Clay	90	280			
Sand	280	300			
			IF MORE SPACE IS NEEDED, USE BACK		

If well telescopes please
sketch and show depths.

GROUND LEVEL

If more than one screen,
show location of each on sketch.

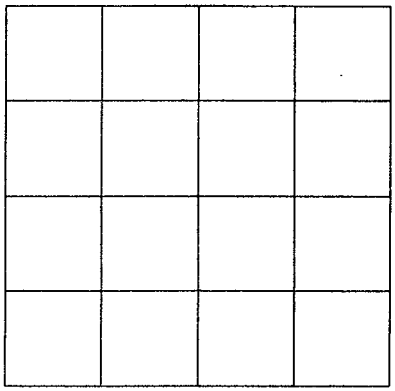

SECTION _____

Please indicate well location X.

ADDITIONAL INFORMATION