MISSISSIPPI DEPARTMENT OF ENVIRONMENTAL QUALITY
Office of Land and Water Resources

P. O. Box 10631
Jackson, MS 39289-0631
WATER WELL DRILLERS LOG

COUNTY WELL LOCATED: Pike.	
WELL NUMBER: L 2/08	CODED:
PERMIT NUMBER:	
NAME OF DRILLING FIRM: Fitzgerald Wellservice	
DATE WELL COMPLETED: 12-5-96	

NAME & MAILING ADDRESS OF LANDOWNER
Obie Simmons.
RR Osyka

WELL LOCATION: SEC 23 TOWNSHIP 1 N/S RANGE 8 E/W

DISTANCE 5 Miles DIRECTION NE of NEAREST TOWN Osyka

OTHER LANDMARK

WELL PURPOSE: Home, Irrigation, Municipal, Industrial, Fish Pond, etc.

PUMP DATA

PUMP TYPE (Circle One): Submersible, Turbine, Jet, Flowing Well, Other (Describe)

POWER TYPE (Circle One): Electric, Tractor, Diesel, Gasoline, Butane, Other (Describe) H/P 1/2

Pump Capacity (GPM)	No. of Stages	Setting Depth
10"	8	60. FT.

PUMP TEST

Well yielded 50 GPM with a drawdown of 1 ft. after 1 hours of pumping

WELL DATA

Well Depth	Casing Diameter (In.)	Casing Length (Ft.)
112"	04"	102'

Type of Casing	Hole Depth	Depth to Static Water Level
PVC	112'	30'

TYPE OF COMPLETION: (Circle One or More): Gravel Packed, Underreamed, Telescoped, Natural Development, Open Hole, Other (Describe)

WELL GROUTED TO A DEPTH OF 10 FEET
Type Grout (circle one): Cement, Bentonite, or Mix

LOG DATA

TYPE OF LOG RUN (Circle One): No Log Run, Electric, Gamma Ray, Density, Sonic, Neutron, Other (Describe)

Name of Organization Running Log

GEOLOGIC DATA (Office Use Only)

Surface Elev.	Geologic Unit	Unit Thickness	Depth to Top
Subs. SWL	Date	Analysis	Aquifer Test

Driller's Remarks

SCREEN DATA

Diameter - Inches	Length - Feet	Slot Size - Inches
4"	10	012

Screen Type	Depth to Bottom - Feet
PVC	112'

Top of Lap Pipe or Reduction in Casing FEET

IF TELESCOPED OR MORE THAN ONE SCREEN, USE BACK PAGE

DESCRIPTION OF FORMATIONS ENCOUNTERED	FROM	TO
Top soil.	0	5
red clay.	5	20
Sand & gravel	20	60
red clay.	60	80
Fine Sand	80	100
course sand.	100	112.

FORMATIONS (continued)

	FROM	TO

IF MORE SPACE IS NEEDED, USE BACK

RECEIVED
JAN 13 1997
Dept. of Environmental Quality
Office of Land & Water Resources

If well telescopes please
sketch and show depths.

GROUND LEVEL

 

If more than one screen,
show location of each on sketch.

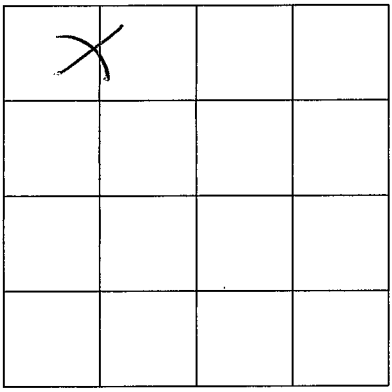

SECTION _____

Please indicate well location X.

ADDITIONAL INFORMATION