PIKE
M68
2-8-75

MISSISSIPPI
BOARD OF WATER COMMISSIONERS
416 North State Street
Jackson, Mississippi 39201

CODED

WATER WELL DRILLERS LOG

Feb 8 1975 — Chester Lewis — Pike
date well completed — firm name — county well located

LANDOWNER: Wesley W. Jackson
Osyka, Mt
(mailing address)

WELL LOCATION:
sec. 17 T 1 N (S) R 9 E (W)
0 miles Cent. of Progress
(distance) (direction) (nearest town)

WELL PURPOSE: Home
(home, irrigation, municipal, industrial)

WELL COMPLETION DATA:

(1) diameter (inches) 4
(2) total depth (feet) 102
(3) static water level (feet) 79 below ~~above~~ top of ground.
(4) casing Plastic (material), bottom (depth)
_____ (size) if telescope see back.
(5) screen 6 (length), 96 ft (depth to top)
4 (size), Plastic (material)
(6) pump 1 HP (HP) 6 (yield gpm)
elect. (type power)
(7) electric log no (yes or no)
_____ (organization running log)
(8) how well bottom plugged Wooden plug

DRILLERS REMARKS: Wood curb fill in - plug well

description of formations encountered	from	to
Red Clay	0	19
Red Sand	19	88
small gravel & sand	88	102

CODED

RECEIVED
FEB 21 1975
MISS. BD. OF WATER COMM

If well telescopes please sketch and show depths.

GROUND LEVEL

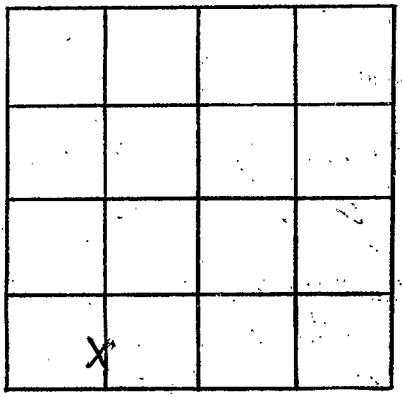

SECTION 17

Please indicate well location X.

ADDITIONAL INFORMATION

If more than one screen, show locations of each on sketch.