PIKE
M 2011
10-23-78

MISSISSIPPI
BOARD OF WATER COMMISSIONERS
416 North State Street
Jackson, Mississippi 39201

WATER WELL DRILLERS LOG

Oct 23 1978 Reeves Mulder Pike
date well completed — firm name — county well located

LANDOWNER: A. J. Bates
Rt 2 McComb
(mailing address)

WELL LOCATION:
sec. 20 T 1 N R 9 E
1 (distance) miles S-SW (direction) of Progress (nearest town)

WELL PURPOSE: home
(home, irrigation, municipal, industrial)

WELL COMPLETION DATA:

(1) diameter (inches) 4"
(2) total depth (feet) 112'
(3) static water level (feet) 80 below ~~above~~ top of ground.
(4) casing Plastic (material), bottom (depth)
— (size) if telescope see back.
(5) screen 5' (length), 107 (depth to top)
4" (size), plastic (material)
(6) pump Cycolene (HP) (yield gpm)
elect (type power)
(7) electric log no (yes or no)
— (organization running log)
(8) how well bottom plugged Wooden plug

DRILLERS REMARKS:

description of formations encountered	from	to
Red Clay	0	22
Red Chally sand	22	98
small gravel sand	98	112

Miss. Board of Water Comm.
FEB 15 1979
RECEIVED

If well telescopes please sketch and show depths.

GROUND LEVEL

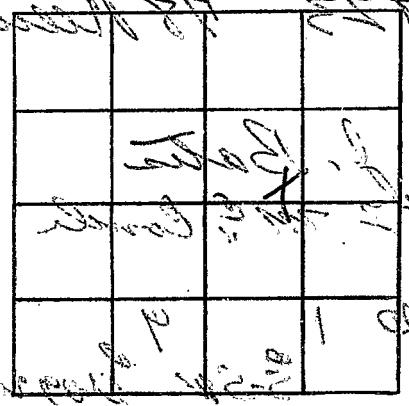

SECTION 20

Please indicate well location X.

ADDITIONAL INFORMATION

If more than one screen, show locations of each on sketch.