PIKE

M 2019

12-11-78

MISSISSIPPI
BOARD OF WATER COMMISSIONERS
416 North State Street
Jackson, Mississippi 39201

WATER WELL DRILLERS LOG

12-11 19 78 Fitzgerald Well Svc Pike
date well completed — firm name — county well located

LANDOWNER: C. L. Rimes

RR. Magnolia
(mailing address)

WELL LOCATION:
sec. 6 T 1 N/S R 9 E/W

8 miles ESE of Magnolia
(distance) (direction) (nearest town)

WELL PURPOSE: Home
(home, irrigation, municipal, industrial)

WELL COMPLETION DATA:

(1) diameter (inches) 4

(2) total depth (feet) 110

(3) static water level (feet) 80 below/~~above~~ top of ground.

(4) casing PVC (material), 102 (depth), 4 (size) if telescope see back.

(5) screen 8 (length), 102 (depth to top), 4 (size), PVC (material)

(6) pump 1/2 (HP) 10 (yield gpm) Elec (type power)

(7) electric log No (yes or no)
(organization running log)

(8) how well bottom plugged Sand Stack

DRILLERS REMARKS:

description of formations encountered	from	to
Red clay	0	20
Red Sand	20	80
Course Sand & gravel	80	110

RECEIVED
JAN 26 1979
MISS. BD. OF WATER COMM.

If well telescopes please sketch and show depths.

GROUND LEVEL

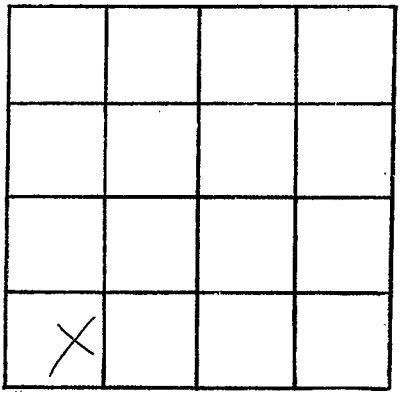

SECTION 6

Please indicate well location X.

ADDITIONAL INFORMATION

If more than one screen, show locations of each on sketch.