MISSISSIPPI DEPARTMENT OF ENVIRONMENTAL QUALITY
Office of Land and Water Resources

P. O. Box 10631
Jackson, MS 39289-0631

WATER WELL DRILLERS LOG

COUNTY WELL LOCATED: Pike	
WELL NUMBER: M 2115	CODED:
DATE WELL COMPLETED: 8-18-99	
PERMIT NUMBER: 0-621	
NAME OF DRILLING FIRM: Daniel Boone	
Tylertown, MS	

NAME & MAILING ADDRESS OF LANDOWNER
Dawn Dubois
3034 Progress Lexie Rd
McComb, MS.

WELL LOCATION	SEC	TOWNSHIP	RANGE
	19	1 (N) S	9 (E) W

DISTANCE	DIRECTION	NEAREST TOWN
1 Miles	SW of	Progress

OTHER LANDMARK

WELL PURPOSE: (Home), Irrigation, Municipal, Industrial, Fish Pond, etc.

PUMP DATA

PUMP TYPE (Circle One): (Submersible), Turbine, Jet, Flowing Well, Other (Describe)

POWER TYPE (Circle One): (Electric), Tractor, Diesel, Gasoline, Butane, Other (Describe) H/P 1

Pump Capacity (GPM)	No. of Stages	Setting Depth
12		125 FT.

PUMP TEST

Well yielded 18 GPM with a drawdown of 16 ft. after 24 hours of pumping

WELL DATA

Well Depth	Casing Diameter (In.)	Casing Length (Ft.)
155'	4"	135'

Type of Casing	Hole Depth	Depth to Static Water Level
PVC	157'	80'

TYPE OF COMPLETION: (Circle One or More): (Gravel Packed), Underreamed, Telescoped, Natural Development, Open Hole, Other (Describe)

WELL GROUTED TO A DEPTH OF 10 FEET
Type Grout (circle one): (Cement), Bentonite, or Mix

LOG DATA

TYPE OF LOG RUN (Circle One): (No Log Run), Electric, Gamma Ray, Density, Sonic, Neutron, Other (Describe)

Name of Organization Running Log

GEOLOGIC DATA (Office Use Only)

Surface Elev.	Geologic Unit	Unit Thickness	Depth to Top
Subs. SWL	Date	Analysis	Aquifer Test

Driller's Remarks

SCREEN DATA

Diameter - Inches	Length - Feet	Slot Size - Inches
4"	20'	.008

Screen Type	Depth to Bottom - Feet
PVC Sch. 40	2'

Top of Lap Pipe or Reduction in Casing
FEET
IF TELESCOPED OR MORE THAN ONE SCREEN: USE BACK PAGE

DESCRIPTION OF FORMATIONS ENCOUNTERED	FROM	TO	FORMATIONS (Continued)	FROM	TO
Clay	0	18			
Gravel	18	92			
Clay	92	114			
Sand	114	157			
			IF MORE SPACE IS NEEDED, USE BACK		

If well telescopes please
sketch and show depths.

GROUND LEVEL

If more than one screen,
show location of each on sketch.

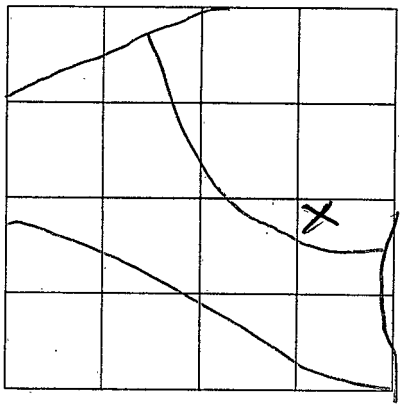

SECTION 19

Please indicate well location X.

ADDITIONAL INFORMATION