MISSISSIPPI DEPARTMENT OF ENVIRONMENTAL QUALITY
Office of Land and Water Resources

P. O. Box 10631
Jackson, MS 39289-0631
WATER WELL DRILLERS LOG

COUNTY WELL LOCATED: Pike	
WELL NUMBER: M-2126	CODED:
DATE WELL COMPLETED: 2-6-01	
PERMIT NUMBER: 113 D-621	
NAME OF DRILLING FIRM: Daniel Boone, Tylertown, MS	

NAME & MAILING ADDRESS OF LANDOWNER
Joyce Cockerham
1064 ED Brumfield Rd.
Osyka, MS

WELL LOCATION: SEC 30 TOWNSHIP 1 (N) S RANGE 9 (E) W

DISTANCE: 8 Miles DIRECTION: E of NEAREST TOWN: Osyka

OTHER LANDMARK:

WELL PURPOSE: Home, Irrigation, Municipal, Industrial, Fish Pond, etc.

PUMP DATA

PUMP TYPE (Circle One): Submersible, Turbine, Jet, Flowing Well, Other (Describe)

POWER TYPE (Circle One): Electric, Tractor, Diesel, Gasoline, Butane, Other (Describe) H/P 1

Pump Capacity (GPM)	No. of Stages	Setting Depth
12		125 FT.

PUMP TEST
Well yielded 16 GPM with a drawdown of 18 ft. after 8 hours of pumping

WELL DATA

Well Depth	Casing Diameter (In.)	Casing Length (Ft.)
148'	4"	126'
Type of Casing	**Hole Depth**	**Depth to Static Water Level**
PVC	150'	92'

TYPE OF COMPLETION: (Circle One or More): Gravel Packed, Underreamed, Telescoped, Natural Development, Open Hole, Other (Describe)

WELL GROUTED TO A DEPTH OF 9 FEET
Type Grout (circle one) Cement, Bentonite, or Mix

LOG DATA

TYPE OF LOG RUN (Circle One): No Log Run, Electric, Gamma Ray, Density, Sonic, Neutron, Other (Describe)

Name of Organization Running Log

GEOLOGIC DATA (Office Use Only)

Surface Elev.	Geologic Unit	Unit Thickness	Depth to Top
Subs. SWL	Date	Analysis	Aquifer Test

Driller's Remarks

SCREEN DATA

Diameter - Inches	Length - Feet	Slot Size - Inches
4"	20'	.008
Screen Type	**Depth to Bottom - Feet**	
PVC Sch. 40	2'	

Top of Lap Pipe or Reduction in Casing FEET

IF TELESCOPED OR MORE THAN ONE SCREEN: USE BACK PAGE

DESCRIPTION OF FORMATIONS ENCOUNTERED	FROM	TO
Clay	0	18
Sand	18	85
Sand + Gravel	85	148
Clay	148	150

FORMATIONS (Continued)	FROM	TO

RECEIVED
MAR 2 3 2001
Dept of Environmental Quality
Office of Land & Water Resources

IF MORE SPACE IS NEEDED, USE BACK

If well telescopes please
sketch and show depths.

GROUND LEVEL

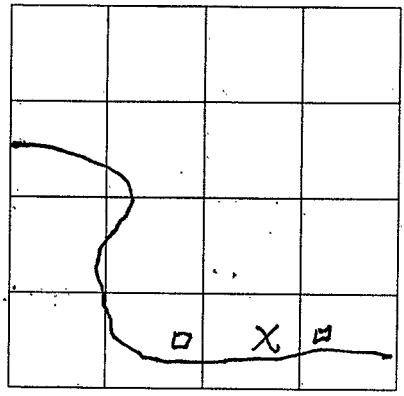

SECTION 30

Please indicate well location X.

ADDITIONAL INFORMATION

If more than one screen,
show location of each on sketch.