MISSISSIPPI DEPARTMENT OF ENVIRONMENTAL QUALITY
Office of Land and Water Resources

P. O. Box 10631
Jackson, MS 39289-0631

WATER WELL DRILLERS LOG

COUNTY WELL LOCATED: Pike	
WELL NUMBER: M-2127	CODED:
DATE WELL COMPLETED: 3-8-01	

113

PERMIT NUMBER: 0-621	
NAME OF DRILLING FIRM: Daniel Boone	
Tylertown MS	

NAME & MAILING ADDRESS OF LANDOWNER:
Greg Mckenzie
1173 Schilling Rd.
Osyka MS

WELL LOCATION	SEC	TOWNSHIP	RANGE
	35	1 (N) S	9 (E) W

DISTANCE	DIRECTION	NEAREST TOWN
1 1/2 Miles	E	of Osyka

OTHER LANDMARK:

WELL PURPOSE: (Home), Irrigation, Municipal, Industrial, Fish Pond, etc.

PUMP DATA

PUMP TYPE (Circle One): (Submersible), Turbine, Jet, Flowing Well, Other (Describe)

POWER TYPE (Circle One): (Electric), Tractor, Diesel, Gasoline, Butane, Other (Describe) H/P 1

Pump Capacity (GPM)	No. of Stages	Setting Depth
12		125 FT.

PUMP TEST

Well yielded 16 GPM with a drawdown of 10 ft. after 8 hours of pumping

WELL DATA

Well Depth	Casing Diameter (In.)	Casing Length (Ft.)
140'	4"	120'
Type of Casing	**Hole Depth**	**Depth to Static Water Level**
PVC	140'	90'

TYPE OF COMPLETION: (Circle One or More): (Gravel Packed), Underreamed, Telescoped, Natural Development, Open Hole, Other (Describe)

WELL GROUTED TO A DEPTH OF 8 FEET
Type Grout (circle one): (Cement), Bentonite, or Mix

LOG DATA

TYPE OF LOG RUN (Circle One): (No Log Run), Electric, Gamma Ray, Density, Sonic, Neutron, Other (Describe)

Name of Organization Running Log:

SCREEN DATA

Diameter - Inches	Length - Feet	Slot Size - Inches
4"	20'	.008
Screen Type		**Depth to Bottom - Feet**
PVC Sch. 40		0

GEOLOGIC DATA (Office Use Only)

Surface Elev.	Geologic Unit	Unit Thickness	Depth to Top
Subs. SWL	Date	Analysis	Aquifer Test

Driller's Remarks:

Top of Lap Pipe or Reduction in Casing
FEET — IF TELESCOPED OR MORE THAN ONE SCREEN: USE BACK PAGE

DESCRIPTION OF FORMATIONS ENCOUNTERED	FROM	TO
Clay	0	12
Sand	12	110
Large Gravel	110	125
Pea Gravel & Sand	125	140

FORMATIONS (Continued)	FROM	TO

RECEIVED
MAR 23 2001
Dept. of Environmental Quality
Office of Land & Water Resources

IF MORE SPACE IS NEEDED, USE BACK

If well telescopes please
sketch and show depths.

GROUND LEVEL

If more than one screen,
show location of each on sketch.

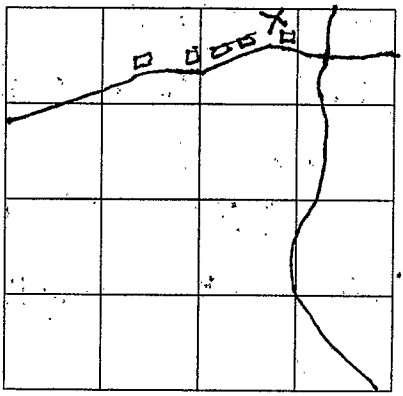

SECTION 35

Please indicate well location X.

ADDITIONAL INFORMATION