

B-62

5-24-62

WATER WELL DRILLERS LOG

Date: 5-21, 1962, Driller: J. F. Murphy, County: Pontotoc

CODED

CODED

(1) Owner of Land: K. Annie Collier

E. R. D. 1 Box 142

(2) Location: 1/4 Sec 21, T. 12 R. 2

2 miles N.W. of Egan

(3) Topography: (Level)

(4) Purpose of Well: (Other)

Description & Color of Materials Sand, Clay, Red Clay, Shell, etc.	Depth Feet	Depth Feet
Soil clay sand	15	15
rock & sand	20	35
Red mud	40	75
sand & rock	75	110

Information upon completion of well:

(1) Diameter 4 inches.

(2) Total Depth 160 feet.

(3) Water Level 20 feet below top of ground.

(4) Cased to 63, Size 4"

(5) Screen: Size \_\_\_\_\_, Length \_\_\_\_\_.


(6) Were any formations sealed against pollution? yes, no.

If YES depth of formation \_\_\_\_\_.

Why \_\_\_\_\_.

Drillers Remarks: \_\_\_\_\_.

CODED

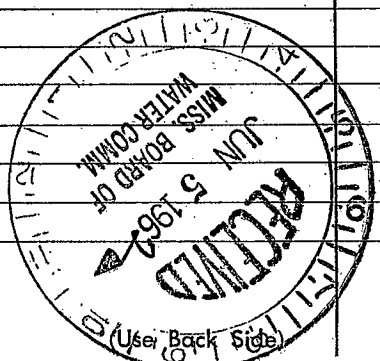

Well No.













