MISSISSIPPI DEPARTMENT OF NATURAL RESOURCES

Bureau of Land and Water Resources

P.O. Box 10631
Jackson, Mississippi 39209

WATER WELL DRILLERS LOG

COUNTY WELL LOCATED: Pontotoc	
WELL NUMBER: B 203	CODED:
DATE WELL COMPLETED: Oct 88	
PERMIT NUMBER:	
NAME OF DRILLING FIRM: LEEPER Drilling, Pontotoc, MS	

NAME & MAILING ADDRESS OF LANDOWNER
Robert Bramlett
RT 1
Pontotoc, MS

WELL LOCATION: SEC 34 TOWNSHIP 9 (N) S RANGE 2 (E) W

DISTANCE 4½ Miles DIRECTION W of NEAREST TOWN Pontotoc

OTHER LANDMARK

WELL PURPOSE: Home, Irrigation, Municipal, Industrial, Fish Pond, etc.
Home

PUMP DATA

PUMP TYPE (Circle One): Submersible, Turbine, Jet, Flowing Well, Other (Describe) _____

POWER TYPE (Circle One): Electric, Tractor, Diesel, Gasoline, Butane, Other (Describe) _____

Pump Capacity (GPM)	No. of Stages	Setting Depth
10	12	126' FT.

PUMP TEST

Well yielded _____ GPM with a drawdown of _____ ft. after _____ hours of pumping

WELL DATA

Well Depth	Casing Diameter (In.)	Casing Length (Ft.)
360	4"	200'
Type of Casing	**Hole Depth**	**Depth to Static Water Level**
PVC	360	90'

TYPE OF COMPLETION: (Circle One or More): Gravel Packed, Underreamed, Telescoped, Natural Development, Open Hole, Other (Describe) _____

Top of Lap Pipe or Reduction in Casing FEET

IF TELESCOPED OR MORE THAN ONE SCREEN, USE BACK PAGE

LOG DATA

TYPE OF LOG RUN (Circle One): No Log Run, Electric, Gamma Ray, Density, Sonic, Neutron, Other (Describe) _____

Name of Organization Running Log

GEOLOGIC DATA (Office Use Only)

Surface Elev.	Geologic Unit	Unit Thickness	Depth to Top
Subs. SWL	Date	Analysis	Aquifer Test

Driller's Remarks

SCREEN DATA

Diameter - Inches	Length - Feet	Slot Size - Inches

Screen Type _____ Depth to Bottom - Feet

DESCRIPTION OF FORMATIONS ENCOUNTERED	FROM	TO	FORMATIONS Continued	FROM	TO
TOP CLAY	0	20			
BLUE CLAY	20	260			
CHALK	260	300			
SAND	300	360			
			IF MORE SPACE IS NEEDED, USE BACK		

RECEIVED
JAN 25 1989
Department of Natural Resources
Bureau of Land & Water Resources

If well telescopes please
sketch and show depths.

GROUND LEVEL

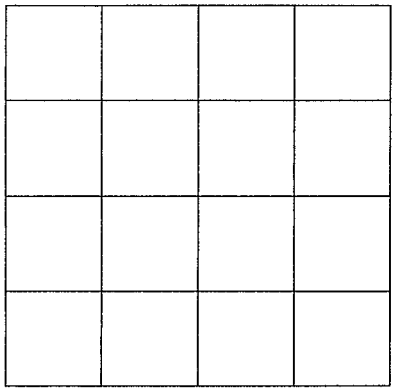

SECTION _____

Please indicate well location X.

ADDITIONAL INFORMATION

If more than one screen,
show location of each on sketch.