MISSISSIPPI DEPARTMENT OF NATURAL RESOURCES

Bureau of Land and Water Resources

P.O. Box 10631
Jackson, Mississippi 39209

WATER WELL DRILLERS LOG

COUNTY WELL LOCATED: Pontotoc	
WELL NUMBER: B	CODED:
2017	
DATE WELL COMPLETED: Oct 1991	

PERMIT NUMBER
NAME OF DRILLING FIRM: Geeper Drilling, Pontotoc

NAME & MAILING ADDRESS OF LANDOWNER: Jimmy Foremand, Rt 1, Ecru MS

WELL LOCATION: SEC 15 TOWNSHIP 9 N (S) RANGE 2 (E) W

DISTANCE ____ Miles DIRECTION ____ of NEAREST TOWN ____

OTHER LANDMARK: Friendship Community

WELL PURPOSE: (Home), Irrigation, Municipal, Industrial, Fish Pond, etc.

PUMP DATA

PUMP TYPE (Circle One): (Submersible), Turbine, Jet, Flowing Well, Other (Describe) ____

POWER TYPE (Circle One): (Electric), Tractor, Diesel, Gasoline, Butane, Other (Describe) ____

Pump Capacity (GPM)	No. of Stages	Setting Depth
10	11	110' FT.

PUMP TEST

Well yielded ____ GPM with a drawdown of ____ ft. after ____ hours of pumping

WELL DATA

Well Depth	Casing Diameter (In.)	Casing Length (Ft.)
285	4"	190
Type of Casing	**Hole Depth**	**Depth to Static Water Level**
PVC	285	70'

TYPE OF COMPLETION: (Circle One or More): Gravel Packed, Underreamed, Telescoped, Natural Development, (Open Hole), Other (Describe) ____

Top of Lap Pipe or Reduction in Casing ____ FEET

IF TELESCOPED OR MORE THAN ONE SCREEN: USE BACK PAGE

LOG DATA

TYPE OF LOG RUN (Circle One): No Log Run, Electric, Gamma Ray, Density, Sonic, Neutron, Other (Describe) ____

Name of Organization Running Log

GEOLOGIC DATA (Office Use Only)

Surface Elev.	Geologic Unit	Unit Thickness	Depth to Top
Subs. SWL	Date	Analysis	Aquifer Test

Driller's Remarks

RECEIVED NOV 06 1991 Dept. of Environmental Quality Bureau of Land & Water Resources

SCREEN DATA

Diameter - Inches	Length - Feet	Slot Size - Inches
Screen Type	**Depth to Bottom - Feet**	

DESCRIPTION OF FORMATIONS ENCOUNTERED	FROM	TO
Top Clay	0	20
Blue Clay	20	60
Chalk + Rock	60	200
Chalk	200	250
Sand	250	285

FORMATIONS (Continued)	FROM	TO

IF MORE SPACE IS NEEDED, USE BACK

If well telescopes please
sketch and show depths.

GROUND LEVEL

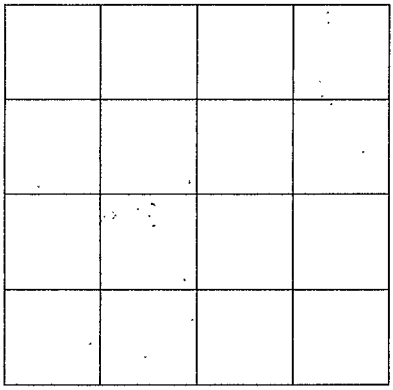

SECTION _____

Please indicate well location X.

ADDITIONAL INFORMATION

If more than one screen,
show location of each on sketch.