

LEE
 2-4-64 CODED

MISSISSIPPI BOARD OF WATER COMMISSIONERS

WATER WELL DRILLERS LOG

Date: Feb 4, 1964, Driller: OTTIS Webb, JR County: PONTIAC
 (Name)


(1) Owner of Land: BYRON HILL
 (Name)
Belden, MISS
 (Address)

(2) Location: SW 1/4, NE 1/4, Sec. 1 T9R4
2 miles NW of Belden
 (distance) (direction) (Nearest Town)

(3) Topography: HILLY
 (Hilly) (Flat) (Level)

(4) Purpose of Well: DOMESTIC
 (Domestic Irrigation, Municipal, Industrial, Other)

| Description & Color of Materials Sand, Clay, Red Clay, Shell, etc. | Thick- ness Feet | Depth Feet |
|---|------------------------|---------------|
| Clay | 0 | 28 |
| Blue MARL | 28 | 230 |
| GREY WATER SAND | 280 | 385 |

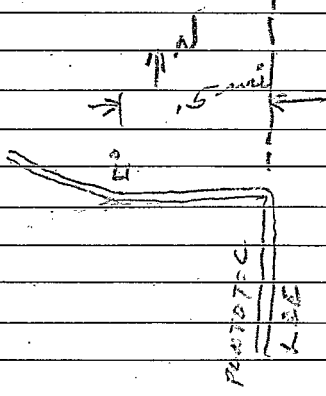

Information upon completion of well:

(1) Diameter 4 inches.

(2) Total Depth 385 feet.

(3) Water Level 130 feet below top of ground.

(4) Cased to 42', Size 4"


(5) Screen: Size _____, Length _____.

(6) Were any formations sealed against pollution?
 _____ yes, _____ no.

If YES depth of formation _____
 Why _____

Drillers Remarks: _____

115 ELEV 400

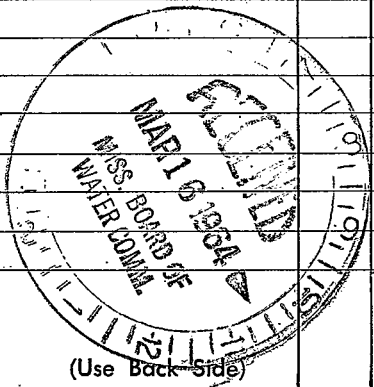

Well No.

(Use Back Side)










