PONTOTOC
D 51
6-21-72

MISSISSIPPI
BOARD OF WATER COMMISSIONERS
416 North State Street
Jackson, Mississippi 39201

WATER WELL DRILLERS LOG

June 21 1972 J. W. Webb & Sons Pontotoc
date well completed — firm name — county well located

LANDOWNER: Bobby Couch

Belden Miss
(mailing address)

WELL LOCATION:
sec. 15 T 9S N S R 4 E W

1 1/4 miles East of Endville
(distance) (direction) (nearest town)

WELL PURPOSE:
(home, irrigation, municipal, industrial)

WELL COMPLETION DATA:

(1) diameter (inches) 5"

(2) total depth (feet) 445

(3) static water level (feet) 105 below above top of ground.

(4) casing Steel (material), 38 ft (depth),
5" (size) if telescope see back.

(5) screen 0 (length), 0 (depth to top)
0 (size), 0 (material)

(6) pump No Pump (HP) (yield gpm)

(type power)

(7) electric log (yes or no)

(organization running log)

(8) how well bottom plugged

DRILLERS REMARKS:

description of formations encountered	from	to
Soil	0	1
Gumbo	1	34
Blue Rock	34	333
Water Rock	333	334
Water Sand	334	445
Coffee Sand		

JUL 17 1972
MISS. BD. OF WATER COMMISSIONERS

If well telescopes please sketch and show depths.

GROUND LEVEL

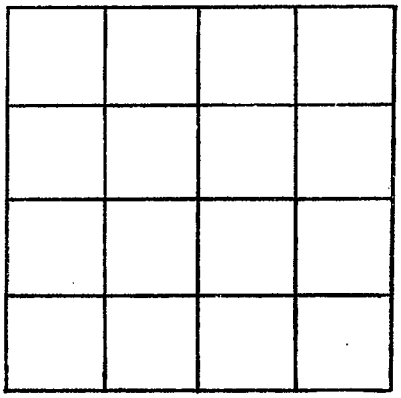

SECTION _____

Please indicate well location X.

ADDITIONAL INFORMATION

If more than one screen, show locations of each on sketch.