MISSISSIPPI DEPARTMENT OF ENVIRONMENTAL QUALITY
Office of Land and Water Resources

P. O. Box 10631
Jackson, MS 39289-0631
WATER WELL DRILLERS LOG

COUNTY WELL LOCATED: Pontotoc	
WELL NUMBER: E19	CODED: ✓
PERMIT NUMBER	
NAME OF DRILLING FIRM: Leeper Drilling, Pontotoc	
DATE WELL COMPLETED: April 1994	

NAME & MAILING ADDRESS OF LANDOWNER
Bill Aaron
Aaron Road
Pontotoc

WELL LOCATION: SEC 9 TOWNSHIP 10 N (S) RANGE 1 (E) W

DISTANCE ____ Miles DIRECTION ____ of NEAREST TOWN ____

OTHER LANDMARK: Near Camp Yocona

WELL PURPOSE: Home, Irrigation, Municipal, Industrial, Fish Pond, etc.: Home

PUMP DATA

PUMP TYPE (Circle One): (Submersible,) Turbine, Jet, Flowing Well, Other (Describe) ____

POWER TYPE (Circle One): (Electric,) Tractor, Diesel, Gasoline, Butane, Other (Describe) ____ H/P 1

Pump Capacity (GPM)	No. of Stages	Setting Depth
7	19	252 FT.

PUMP TEST

Well yielded ____ GPM with a drawdown of ____ ft. after ____ hours of pumping

WELL DATA

Well Depth	Casing Diameter (In.)	Casing Length (Ft.)
675'	4½"	340'
Type of Casing	**Hole Depth**	**Depth to Static Water Level**
SDR17 PVC	675'	190'

TYPE OF COMPLETION: (Circle One or More): Gravel Packed, Underreamed, (Telescoped,) Natural Development, Open Hole, Other (Describe) ____

WELL GROUTED TO A DEPTH OF 10 FEET
Type Grout (circle one): Cement, (Bentonite, or Mix)

LOG DATA

TYPE OF LOG RUN (Circle One): No Log Run, Electric, Gamma Ray, Density, Sonic, Neutron, Other (Describe) ____

Name of Organization Running Log

GEOLOGIC DATA (Office Use Only)

Surface Elev.	Geologic Unit	Unit Thickness	Depth to Top
Subs. SWL	Date	Analysis	Aquifer Test

Driller's Remarks: 4½ x 2" Well

SCREEN DATA

Diameter - Inches	Length - Feet	Slot Size - Inches
2"	40'	.010
Screen Type	**Depth to Bottom - Feet**	
Slotted PVC	675'	

DESCRIPTION OF FORMATIONS ENCOUNTERED	FROM	TO	FORMATIONS (Continued)	FROM	TO
Top Clay	0	20			
Blue Clay	20	400			
Chalk	400	600			
Sand	600	675			
			IF MORE SPACE IS NEEDED, USE BACK		

RECEIVED
DEC 11 1995
Dept. of Environmental Quality
Office of Land & Water Resources

If well telescopes please
sketch and show depths.

GROUND LEVEL

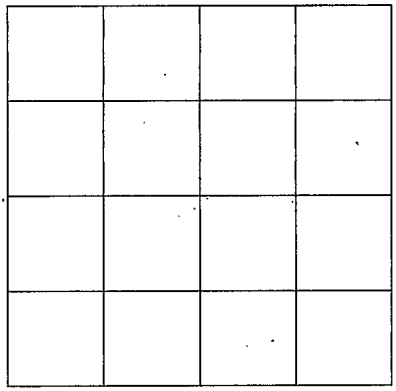

SECTION _____

Please indicate well location X.

ADDITIONAL INFORMATION

If more than one screen,
show location of each on sketch.