

CODED

WATER WELL DRILLERS LOG

Date: 1-29, 19 65, Driller: LAMAR WILDET County PONTOTOC

(Name)

(1) Owner of Land: LEONARD JENKINS
(Name)

SPRINGVILLE MISS.
(Address)

(2) Location: 8 1052E
13 miles SW of PONTOTOC
(distance) (direction) (Nearest Town)

(3) Topography: FLAT WOODS
(Hilly) (Flat) (Level)

(4) Purpose of Well: PRIVATE HOME
(Domestic Irrigation
Municipal, Industrial, Other)

Description & Color of Materials Sand, Clay, Red Clay, Shell, etc.	Thick- ness Feet	Depth Feet
<u>GREY BOERSHOT</u>	<u>18</u>	<u>18</u>
<u>BLUE SHALE MIXED WITH LIMESTONE & BLACK ROCK</u>	<u>72</u>	<u>90</u>
<u>BLUE SHALE</u>	<u>148</u>	<u>248</u>
<u>WHITE ROCK & SAND</u>	<u>42</u>	<u>286</u>

CODED

Information upon completion of well:

(1) Diameter 4 inches.

(2) Total Depth 286 feet.

(3) Water Level 60 feet below top of ground.

(4) Cased to 96', Size 4"

(5) Screen: Size _____, Length _____


(6) Were any formations sealed against pollution?

_____ yes, _____ no.

If YES depth of formation _____

Why _____

Drillers Remarks: _____

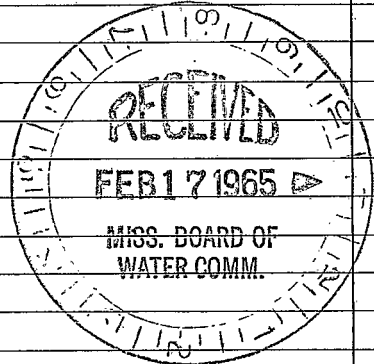

(Use Back Side)

Well No.
































