

PONTOTOC
G-37
3-7-62

WATER WELL DRILLERS LOG

Date: 3-7, 1962, Driller: Y & Missy County, Pontotoc
(Name)

CODED

- (1) Owner of Land: Y & Missy
(Name)
algona
(Address)
- (2) Location: 1/4 NW 1/4, Sec. 31, T12R36
1/2 miles W, of algona
(distance) (direction) (Nearest Town)
- (3) Topography: X
(Hilly) (Flat) (Level)
- (4) Purpose of Well:
(Domestic Irrigation
Municipal, Industrial, Other)

Description & Color of Materials Sand, Clay, Red Clay, Shell, etc.	Thick- ness Feet	Depth Feet
<u>soil + clay</u>	<u>15</u>	<u>15</u>
<u>sand</u>	<u>10</u>	<u>25</u>
<u>rock + sand</u>	<u>25</u>	<u>50</u>
<u>sand</u>	<u>15</u>	<u>65</u>
<u>blue marl</u>	<u>ND</u>	<u>115</u>
<u>sand + rock</u>	<u>60</u>	<u>175</u>


Information upon completion of well:

- (1) Diameter 4 inches.
- (2) Total Depth 175 feet.
- (3) Water Level 46 feet below top of ground.
- (4) Cased to 44, Size 4
- (5) Screen: Size _____, Length _____
- (6) Were any formations sealed against pollution?
_____ yes, _____ no.

CODED

If YES depth of formation _____
Why _____

Drillers Remarks: _____

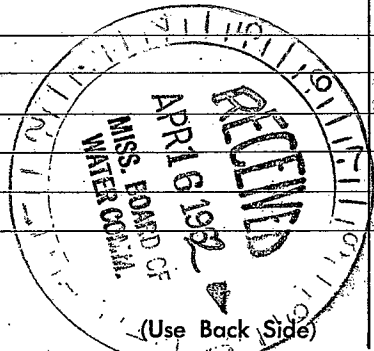

Well No. _____















