Pontotoc
L-27
6-14-68

MISSISSIPPI
BOARD OF WATER COMMISSIONERS
416 North State Street
Jackson, Mississippi 39201

CODED

WATER WELL DRILLERS LOG

date well completed 19 Lamar Wilder firm name Pontotoc county well located

LANDOWNER: June 14
Mitchell Duke
Rt-1- Pontotoc
(mailing address)

WELL LOCATION:
sec 35 T 11 N/S R 3 E/W
12 (distance) miles S (direction) of Pontotoc (nearest town)

WELL PURPOSE: Home
(home, irrigation, municipal, industrial)

WELL COMPLETION DATA:

(1) diameter (inches) 4
(2) total depth (feet) 1008
(3) static water level (feet) 210 below above top of ground.
(4) casing Steel (material), 268 (depth),
4" (size) if telescope see back.
(5) screen ~~(length)~~, ~~(depth to top)~~
~~(size)~~, ~~(material)~~
(6) pump 3/4 (HP) 5 (yield gpm)
Electric (type power)
(7) electric log No (yes or no)
(organization running log)
(8) how well bottom plugged

DRILLERS REMARKS:

description of formations encountered	from	to
Red Sand	0	60
Blue Shale	60	110
Rock + Sand	110	200
Blue Shale	200	600
Greyish Shale	600	760
Rock	760	772
Sandy Shale	772	850
Rock + Sand	850	1008

CODED

JUL - 8 19..
MISS. BO...
WATER C...

If well telescopes please sketch and show depths.

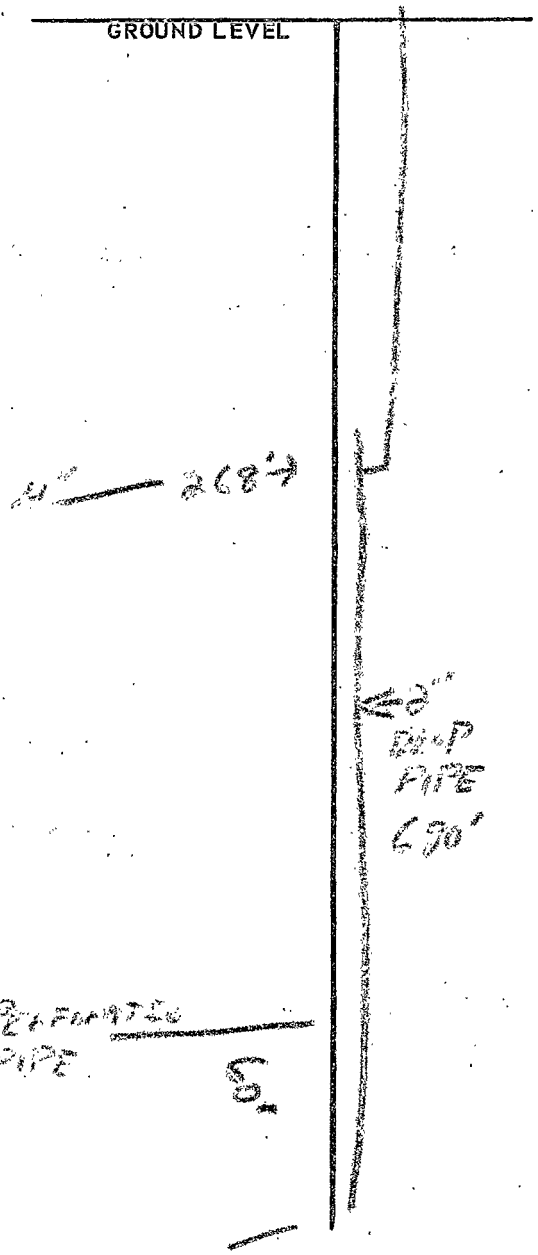

If more than one screen, show locations of each on sketch.

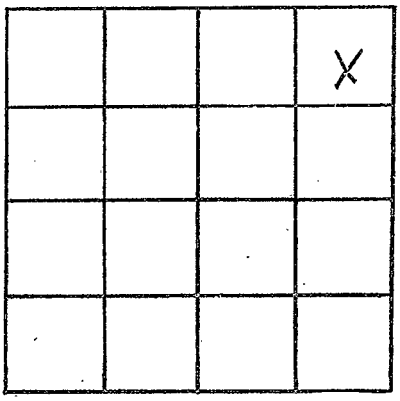

SECTION 35

Please indicate well location X.

ADDITIONAL INFORMATION