PONTOTOC
M27
3-73

MISSISSIPPI
BOARD OF WATER COMMISSIONERS
416 North State Street
Jackson, Mississippi 39201

CODED

WATER WELL DRILLERS LOG

March 19 73 Herndon Well & Supply Company Pontotoc
date well completed — firm name — county well located

LANDOWNER:
Don Mallory
Rt. 1, Shannon, MS 38868
(mailing address)

WELL LOCATION:
sec. 1 T 11 N (S) R 4 (E) W

8 (distance) miles W (direction) of Shannon (nearest town)

WELL PURPOSE: Home
(home, irrigation, municipal, industrial)

WELL COMPLETION DATA:

(1) diameter (inches) 5 inch

(2) total depth (feet) 750

(3) static water level (feet) 203 below ~~above~~ top of ground.

(4) casing steel (material), 335 (depth),
5 (size) if telescope see back.

(5) screen 63" Perf Pipe (length), 687 (depth to top)
2" (size), Steel (material)

(6) pump 1 (HP) 100 (yield gpm)
Electric (type power)

(7) electric log No (yes or no)
(organization running log)

(8) how well bottom plugged
Backwash valve

DRILLERS REMARKS:

description of formations encountered	from	to
Red Clay	0	25
Blue Rock	25	505
Sand	505	750

CODED

MAY 1 1973
MISS. WR. CO.

If well telescopes please sketch and show depths.

GROUND LEVEL

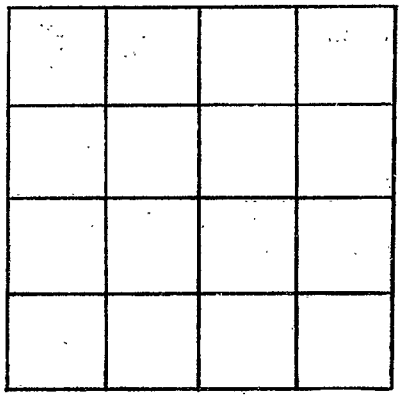

SECTION _____

Please indicate well location X.

ADDITIONAL INFORMATION

If more than one screen, show locations of each on sketch.