

MISSISSIPPI BOARD OF WATER COMMISSIONERS

Prentiss  
A-52  
9-66

WATER WELL DRILLERS LOG

Date: Sept 16, 1966, Driller: **BONDS PLUMBING & DRILLING CO.** County: Prentiss  
(Name)

(1) Owner of Land:	Description & Color of Materials Sand, Clay, Red Clay, Shell, etc.	Thick- ness Feet	Depth Feet
<u>William White</u> (Name) <u>Booneville Miss St</u> (Address)	<u>Red Sand</u>	<u>18</u>	
(2) Location: <u>N W 1/4, 1/4, Sec. 16 T5 R E</u>	<u>Blue Clay</u>	<u>282</u>	
<u>10</u> miles <u>W</u> west of <u>Booneville</u> (distance) (direction) (Nearest Town)	<u>white water sand</u>	<u>60</u>	<u>360</u>
(3) Topography: <u>Flat</u> (Hilly) (Flat) (Level)			
(4) Purpose of Well: <u>Domestic</u> (Domestic Irrigation Municipal, Industrial, Other)			

Information upon completion of well:


- (1) Diameter 4 inches.
- (2) Total Depth 360 feet.
- (3) Water Level 140 feet below top of ground.
- (4) Cased to 21, Size 4
- (5) Screen: Size None, Length \_\_\_\_\_
- (6) Were any formations sealed against pollution?  
\_\_\_\_\_ yes, \_\_\_\_\_ no.

If YES depth of formation \_\_\_\_\_

Why \_\_\_\_\_

Drillers Remarks: \_\_\_\_\_

**CODED**

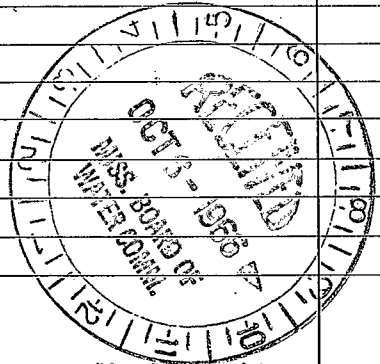

(Use Back Side)

Well No.

Retain this copy for your office files.


