PRENTISS
C12
10-21-69

MISSISSIPPI
BOARD OF WATER COMMISSIONERS
416 North State Street
Jackson, Mississippi 39201

CODED

WATER WELL DRILLERS LOG

10-21 1969 Bonds Water Wells Prentiss
date well completed firm name county well located

LANDOWNER: Don McDaniel

Booneville
(mailing address)

WELL LOCATION:
sec. 20 T 4 N (S) R 8 (E) (W)
12 miles East of Booneville
(distance) (direction) (nearest town)

WELL PURPOSE: Home
(home, irrigation, municipal, industrial)

WELL COMPLETION DATA:

(1) diameter (inches) 4
(2) total depth (feet) 160
(3) static water level (feet) 80 below above top of ground.
(4) casing Steel (material), 37 (depth),
— (size) if telescope see back.
(5) screen None (length) (depth to top)
(size), (material)
(6) pump Hand (HP) Air Compressor (yield gpm)
(type power)
(7) electric log no (yes or no)
(organization running log)
(8) how well bottom plugged Open

DRILLERS REMARKS:

description of formations encountered	from	to
Yellow sand	0	32
Blue clay	32	120
Water sand	120	160

NOV 20 1969

MISS. DEPT. OF WATER COMMISS.

If well telescopes please sketch and show depths.

GROUND LEVEL

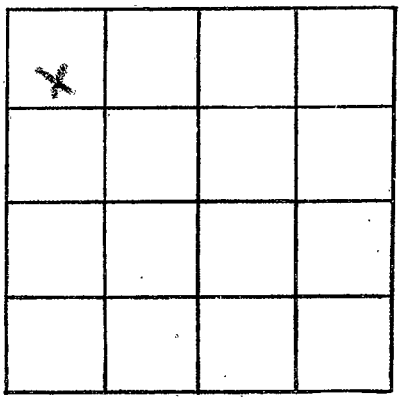

SECTION _____

Please indicate well location X.

ADDITIONAL INFORMATION

If more than one screen, show locations of each on sketch.