PRENTISS
F 64

CODED

MISSISSIPPI DEPARTMENT OF NATURAL RESOURCES

Bureau of Land and Water Resources
Southport Mall
P.O. Box 10631
Jackson, Mississippi 39209

WATER WELL DRILLERS LOG

02 March 19 87 Herndon Well & Supply, Inc. Prentiss
date well completed — firm name — county well located

LANDOWNER: H & W Industries
Booneville, MS 38829
(mailing address)

WELL LOCATION:
sec. 3 T. 5 N~~X~~ S R. 7 E ~~XXX~~
Inside City Limits
(distance) miles (direction) of (nearest town)

WELL PURPOSE: Industrial
(home, irrigation, municipal, industrial)

WELL COMPLETION DATA:

(1) diameter (inches) 12 x 8"
(2) total depth (feet) 471'
(3) static water level (feet) 179' below ~~above~~ top of ground.
(4) casing Steel (material), 421' (depth), 12" (size) if telescope see back.
(5) screen 51' (length), 420' (depth to top), 8" (size), SS Ribbed (material)
(6) pump 60 (HP) 578 (yield gpm) Electric (type power)
(7) electric log yes (yes or no) Herndon Well (organization running log)
(8) how well bottom plugged 8" BWV @ 471'

DRILLERS REMARKS:

description of formations encountered	from	to
Brown Clay	0	8
Yellow Coarse Sand	8	38
Blue Clay	38	60
Shale Rock		60
Blue Clay	60	95
Sand	95	140
Blue Clay	140	186
Shale Rock	186	186
Blue Clay	186	205
Shale Rock	20	205
Blue Clay	205	248
Rock	248	249
Blue Clay	249	297
Rock	297	298
Blue Clay	298	320
Snady Vlue Clay	320	380
Shale Rock	380	380
Blue Clay few Sand Strks.	380	420
Gravel & Sand	420	480
Gravel & Clay Streaks	480	490

CODED

RECEIVED
MAY 7 1987
Department of Natural Resources
Bureau of Land & Water Resources

If well telescopes please sketch and show depths.

GROUND LEVEL

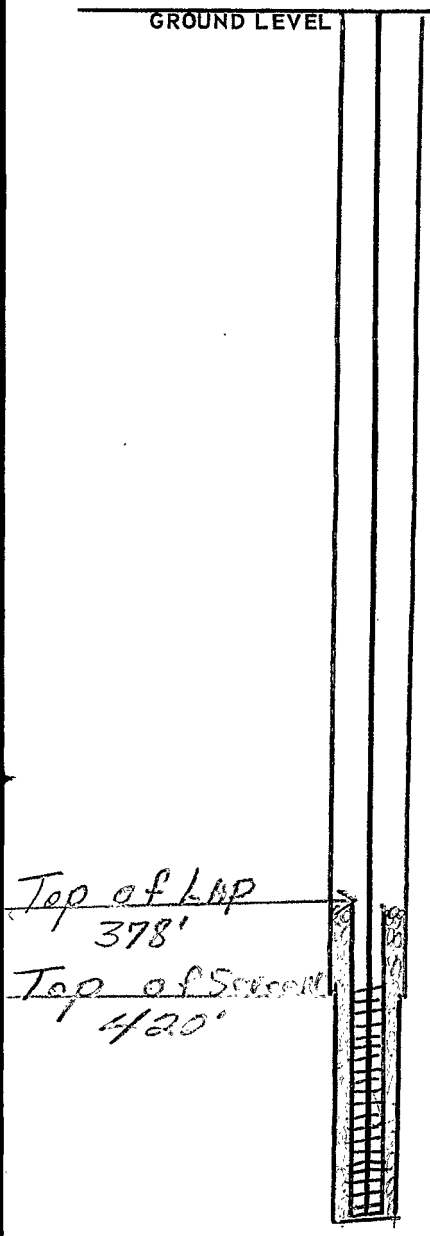

If more than one screen, show locations of each on sketch.

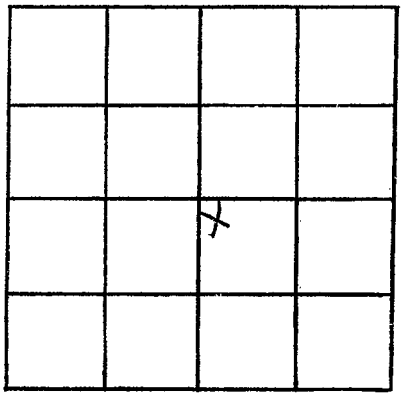

SECTION _____

Please indicate well location X.

ADDITIONAL INFORMATION