MISSISSIPPI DEPARTMENT OF ENVIRONMENTAL QUALITY
Bureau of Land and Water Resources

P. O. Box 10631
Jackson, MS 39289-0631
WATER WELL DRILLERS LOG

COUNTY WELL LOCATED	Prentiss
WELL NUMBER	F-2013
CODED	
DATE WELL COMPLETED	08/16/00
PERMIT NUMBER	
NAME OF DRILLING FIRM	Herndon Well
	Shannon MS

NAME & MAILING ADDRESS OF LANDOWNER
Danny McAnally
CR 1000, Box 105A
Booneville, MS 38829

WELL LOCATION: SEC 2 TOWNSHIP 5 S RANGE 7 E

DISTANCE 1 Miles DIRECTION NE of NEAREST TOWN Booneville

OTHER LANDMARK

WELL PURPOSE: Home, Irrigation, Municipal, Industrial, Fish Pond, etc.
Home

PUMP DATA

PUMP TYPE (Circle One): Submersible, Turbine, Jet Flowing Well, Other (Describe)

POWER TYPE (Circle One): Electric, Tractor, Diesel, Gasoline, Butane, Other (Describe) H/P 1½

Pump Capacity (GPM)	No. of Stages	Setting Depth
25	15	126' FT.

PUMP TEST

Well yielded _____ GPM with a drawdown of _____ ft. after _____ hours of pumping

WELL DATA

Well Depth	Casing Diameter (In.)	Casing Length (Ft.)
160'	4"	118'
Type of Casing	Hole Depth	Depth to Static Water Level
PVC		

TYPE OF COMPLETION: (Circle One or More): Gravel Packed, Underreamed, Telescoped, Natural Development, Open Hole, Other (Describe)

Top of Lap Pipe or Reduction in Casing FEET

IF TELESCOPED OR MORE THAN ONE SCREEN: USE BACK PAGE

LOG DATA

TYPE OF LOG RUN (Circle One): No Log Run, Electric, Gamma Ray, Density, Sonic, Neutron, Other (Describe)

Name of Organization Running Log

GEOLOGIC DATA (Office Use Only)

Surface Elev.	Geologic Unit	Unit Thickness	Depth to Top
Subs. SWL	Date	Analysis	Aquifer Test

Driller's Remarks

SCREEN DATA

Diameter - Inches	Length - Feet	Slot Size - Inches
4"	20'	.010
Screen Type	Depth to Bottom - Feet	
PVC	160'	

DESCRIPTION OF FORMATIONS ENCOUNTERED	FROM	TO	FORMATIONS (Continued)	FROM	TO
Red Clay	0	15			
Red Sand	15	30			
Blue Clay	30	97			
Sand	97	145			
Blue Clay	145	160			
Rock @ 100'					
			IF MORE SPACE IS NEEDED, USE BACK		

RECEIVED
AUG 17 2000
Dept. of Environmental Quality
Office of Land & Water Resources

If well telescopes please
sketch and show depths.

GROUND LEVEL

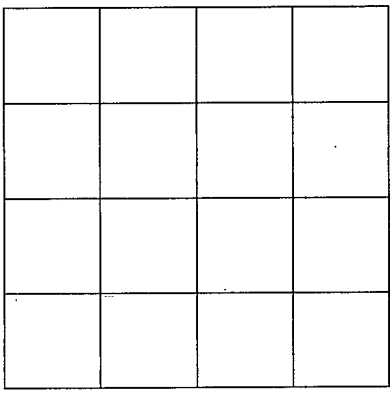

SECTION _____

Please indicate well location X.

ADDITIONAL INFORMATION

If more than one screen,
show location of each on sketch.