

J

10-11-62

WATER WELL DRILLERS LOG

HERNDON WELL & SUPPLY CO.

Date: Oct 11, 1962, Driller: _____ P. O. BOX #2 _____ County Lee

SHANNON, MISSISSIPPI

	Description & Color of Materials Sand, Clay, Red Clay, Shell, etc.	Thick- ness Feet	Depth Feet
(1) Owner of Land: <u>Preston Robbins</u> (Name) <u>Bullinger, Missa</u> (Address)	<u>sand & clay</u>		<u>0</u>
(2) Location: _____ 1/4, _____ 1/4, Sec. _____ T. R. _____ _____ miles <u>N</u> _____ of <u>Bullinger</u> (distance) (direction) (Nearest Town)	<u>blue sand</u>		<u>25</u>
(3) Topography: _____ (Hilly) <u>Flat</u> (Flat) (Level)	<u>sand</u>		<u>60</u>
(4) Purpose of Well: _____ (Domestic Irrigation Municipal, Industrial, Other)	<u>Bottom</u>		<u>100</u>


Information upon completion of well:

- (1) Diameter 4 inches.
- (2) Total Depth 180 feet.
- (3) Water Level _____ feet below top of ground.
- (4) Cased to 30', Size 4'
- (5) Screen: Size _____, Length _____
- (6) Were any formations sealed against pollution?
 yes, _____ no.

If YES depth of formation 25'

Why surface & sand

Drillers Remarks: _____

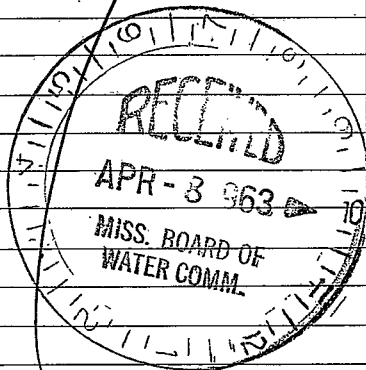

(Use Back Side)

Well No.




