Prentiss
J90
11-74
Elg #66

MISSISSIPPI
BOARD OF WATER COMMISSIONERS
416 North State Street
Jackson, Mississippi 39201

CODED

WATER WELL DRILLERS LOG

November 1974 Herndon Well & Supply, Inc. Prentiss
date well completed — firm name — county well located

LANDOWNER:
City of Baldwyn

Baldwyn, MS
(mailing address)

WELL LOCATION:
sec. 26 T 6 S R 6 E

inside miles City of Baldwyn
(distance) (direction) (nearest town)

WELL PURPOSE: Municipal
(home, irrigation, municipal, industrial)

WELL COMPLETION DATA:

(1) diameter (inches) 10 x 6

(2) total depth (feet) 380

(3) static water level (feet) 37 below top of ground.

(4) casing Steel (material), 310 (depth),
10" (size) if telescope see back.

(5) screen 70Ft. (length), (depth to top)
6 in. (size), Stainless Steel (material)

(6) pump 40 (HP) 362 (yield gpm)
Elec. (type power)

(7) electric log yes (yes or no)
USGS (organization running log)

(8) how well bottom plugged BWV

DRILLERS REMARKS:

description of formations encountered	from	to
Red Clay	0	15
Red Sand	15	42
Blue Clay	42	45
Blue Sandy Clay	45	58
Blue Tight Sand	58	82
Blue Clay - Sandy	82	95
Sand - Fine - Blue	95	106
Hard Rock	106	108
Tight Sand	108	140
Tight Sand - Streaks of sand	140	220
Sand , Fine	220	245
Shale	245	265
Fine Sand	265	310
Sand	310	385
Sand - Streaks/clay	385	430
Gravel Streaks/clay	430	480

CODED

RECEIVED
DEC 26 1974
MISS. BD. OF WATER COMM.

If well telescopes please sketch and show depths.

GROUND LEVEL

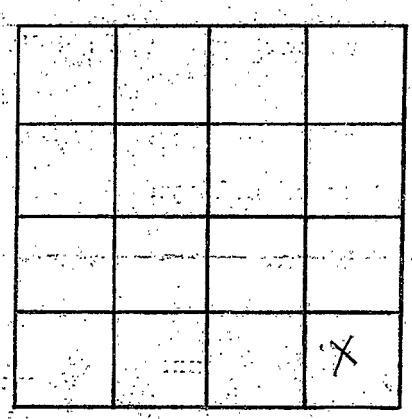

SECTION 26

Please indicate well location X.

ADDITIONAL INFORMATION

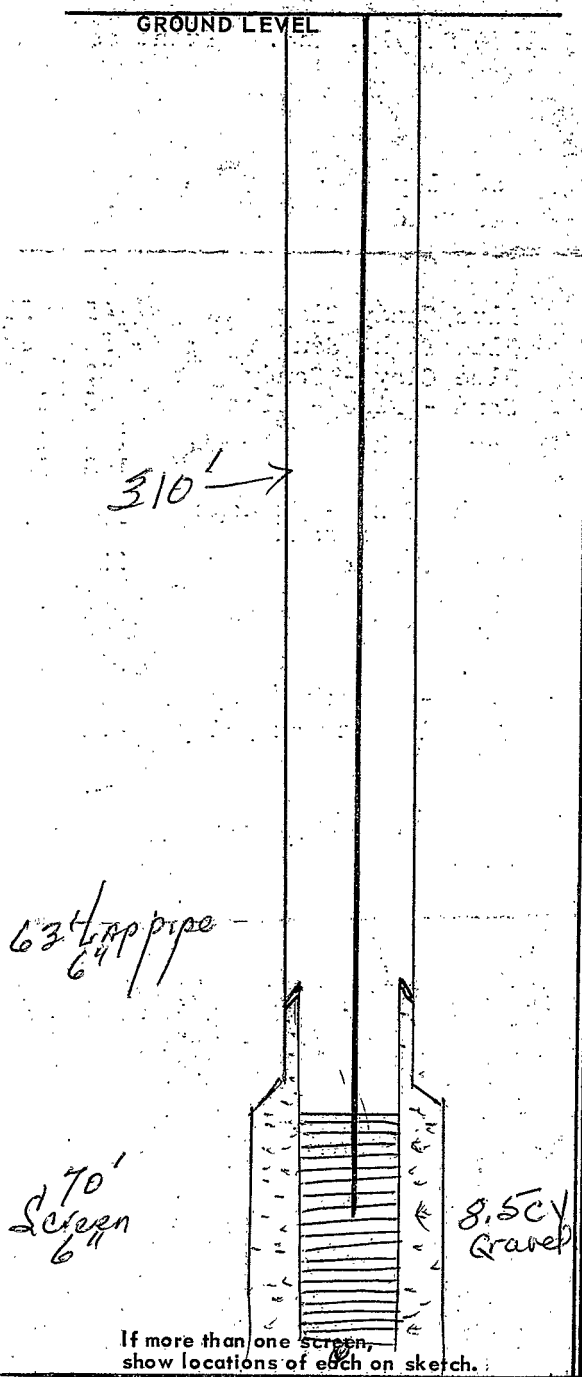

If more than one screen, show locations of each on sketch.