Prentiss
L 53
9-30-71

MISSISSIPPI
BOARD OF WATER COMMISSIONERS
416 North State Street
Jackson, Mississippi 39201

CODED

WATER WELL DRILLERS LOG

9-30 1971 Bonds Well Drilling Prentiss
date well completed firm name county well located
1ST Gra. TO LT. 2nd TRAIL ON LT.

LANDOWNER: James L. Stacy

Booneville Miss
(mailing address)

WELL LOCATION:
sec 32 T 6 N/S R 8 E/W
12 (distance) miles S-E (direction) of Booneville (nearest town)

WELL PURPOSE: Home
(home, irrigation, municipal, industrial)

WELL COMPLETION DATA:

(1) diameter (inches) 4
(2) total depth (feet) 130
(3) static water level (feet) 69 below/above top of ground.
(4) casing Steel (material), 39 (depth),
_____ (size) if telescope see back.
(5) screen None (length) (depth to top)
_____ (size), _____ (material)
(6) pump 3/4 (HP) 5 (yield gpm)
Air Pump (type power)
(7) electric log No (yes or no)
_____ (organization running log)
(8) how well bottom plugged Open

DRILLERS REMARKS: _____

description of formations encountered	from	to
Red Clay	0	33
Blue Clay	33	87
Water Sand	87	130

CODED

OCT 4 1971
MISS. BD. OF
WATER COMM.

If well telescopes please sketch and show depths.

GROUND LEVEL

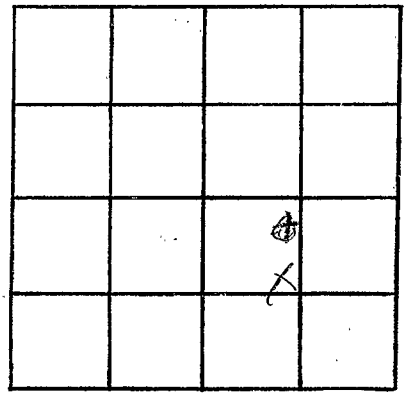

SECTION 32

Please indicate well location X.

ADDITIONAL INFORMATION

If more than one screen, show locations of each on sketch.