Quitman
E 45
9-19-75

MISSISSIPPI
BOARD OF WATER COMMISSIONERS
416 North State Street
Jackson, Mississippi 39201

WATER WELL DRILLERS LOG

CODED

Sep 19 1975 North Miss Well Drilling Quitman
date well completed — firm name — county well located

LANDOWNER: Self + Company
Marks Miss
(mailing address)

WELL LOCATION:
sec 36 T 28 N S R 1 E W 15E
1 miles E of Marks
(distance) (direction) (nearest town)

WELL PURPOSE: Home
(home, irrigation, municipal, industrial)

WELL COMPLETION DATA:

(1) diameter (inches) 2"
(2) total depth (feet) 60
(3) static water level (feet) 15 below ~~above~~ top of ground.
(4) casing Plastic (material), 60 (depth),
_____ (size) if telescope see back.
(5) screen 10' (length), 50 (depth to top)
2" (size), Plastic (material)
(6) pump 1 (HP) 15 (yield gpm)
Elec (type power)
(7) electric log No (yes or no)
_____ (organization running log)
(8) how well bottom plugged Plug

DRILLERS REMARKS:

description of formations encountered	from	to
Clay	0	15
Sand	15	60

CODED

RECEIVED
OCT - 1 1975
MISS. BD. OF WATER COMM.

If well telescopes please sketch and show depths.

GROUND LEVEL

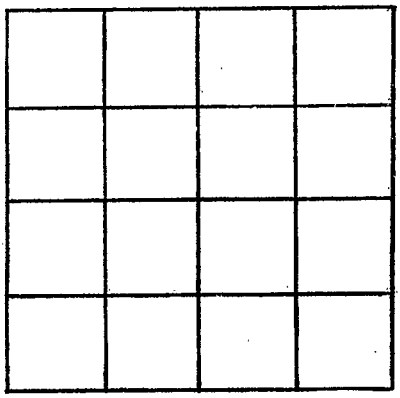

SECTION _____

Please indicate well location X.

ADDITIONAL INFORMATION

If more than one screen, show locations of each on sketch.