Quitman
G 25
3-30-70

MISSISSIPPI
BOARD OF WATER COMMISSIONERS
416 North State Street
Jackson, Mississippi 39201

CODED

WATER WELL DRILLERS LOG

3-30-70 19 Dixie Coop Farmers Quitman
date well completed — firm name — county well located

LANDOWNER: Stark + Turnage
Water Valley, Miss
(mailing address)

WELL LOCATION:
sec 34 T 27 (N) (S) R 2 (E) (W)
2 miles (distance) West (direction) of Bell (nearest town)

WELL PURPOSE: home
(home, irrigation, municipal, industrial)

WELL COMPLETION DATA:
(1) diameter (inches) 2½ 24
(2) total depth (feet) 894
(3) static water level (feet) 5 below above top of ground.
(4) casing (material), (depth), 2½ 24 (size) if telescope see back.
(5) screen 30 (length), 864 (depth to top)
2½" (size), Stainless Steel (material)
(6) pump 2 (HP) 40 GPM (yield gpm)
Electric (type power)
(7) electric log (yes or no)
(organization running log)
(8) how well bottom plugged

DRILLERS REMARKS:

description of formations encountered	from	to
Clay		36
Sand	36	72
Sand + gravel	72	152
Clay + rock layers	152	217
Clay	217	455
Sand	455	520
Clay + Sand	520	737
Sand	737	825
Sand w/ Lignite	825	847
Sand	847	868
~~Clay~~		
Meridian Sand	868	894

CODED

MAY 4 1970
MISS. BDA. OF WATER COMM.

If well telescopes please sketch and show depths.

GROUND LEVEL

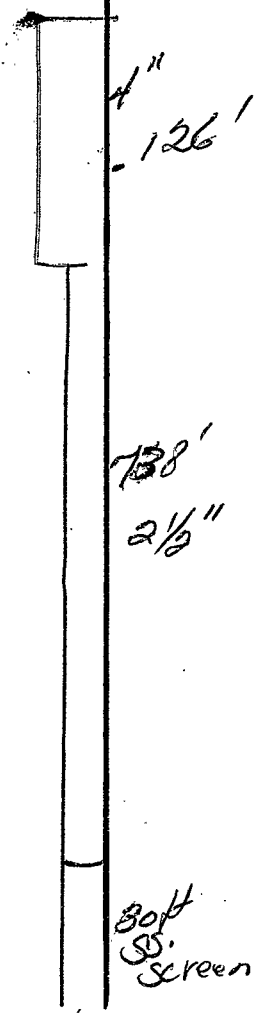

If more than one screen, show locations of each on sketch.

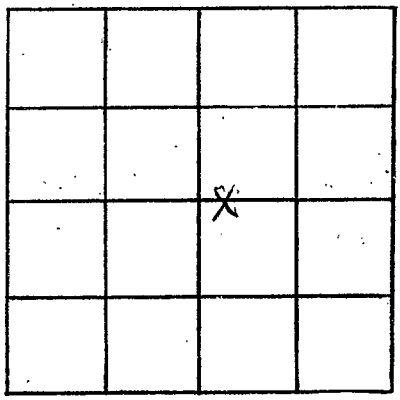

SECTION 3C

Please indicate well location X.

ADDITIONAL INFORMATION