Quitman
H
2021

MISSISSIPPI
BOARD OF WATER COMMISSIONERS
416 North State Street
Jackson, Mississippi 39201

WATER WELL DRILLERS LOG

6-13-82 19 — date well completed
Austin Cain Well Serv — firm name
Quitman ~~Panola~~ — county well located

LANDOWNER: W.A. Allgood
Rt 1 Box 220
Marks MS
(mailing address)

WELL LOCATION:
sec. 2 T 22 N✓ S R 1 E✓ W
4 (distance) miles S-E (direction) of Marks (nearest town)

WELL PURPOSE: Home
(home, irrigation, municipal, industrial)

WELL COMPLETION DATA:

(1) diameter (inches) 2
(2) total depth (feet) 65'
(3) static water level (feet) 12 below/above top of ground.
(4) casing PVC (material), 65' (depth),
_____ (size) if telescope see back.
(5) screen 10 (length), 55' (depth to top)
2 (size), PVC (material)
(6) pump 1/3 (HP) 5 (yield gpm)
Elect (type power)
(7) electric log _____ (yes or no)
_____ (organization running log)
(8) how well bottom plugged PVC Cap

DRILLERS REMARKS:

description of formations encountered	from	to
Humus	0	18
Sand	18	65

DEPT. OF NATURAL RESOURCES
BUREAU OF LAND & WATER RESOURCES
JUL 19 1982
RECEIVED

If well telescopes please sketch and show depths.

GROUND LEVEL

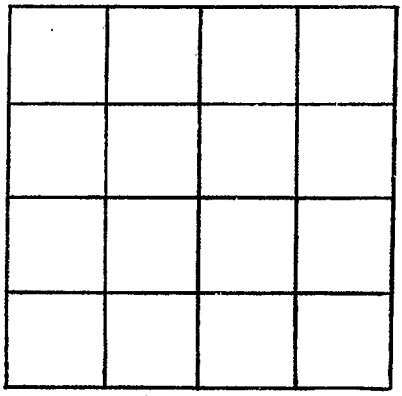

SECTION _____

Please indicate well location X.

ADDITIONAL INFORMATION

If more than one screen, show locations of each on sketch.