MISSISSIPPI DEPARTMENT OF ENVIRONMENTAL QUALITY
Office of Land and Water Resources

P. O. Box 10631
Jackson, MS 39289-0631

WATER WELL DRILLERS LOG

COUNTY WELL LOCATED	Quitman
WELL NUMBER	25
CODED	
	H-2005
DATE WELL COMPLETED	4-28-01
PERMIT NUMBER	
NAME OF DRILLING FIRM	Bryant Well & Pump 0-639

NAME & MAILING ADDRESS OF LANDOWNER
Erlie Robinson
Air Port Rd.
Marks MS

WELL LOCATION	SEC	TOWNSHIP	RANGE
	3	27 (N) S	1 E (W)

DISTANCE	DIRECTION	NEAREST TOWN
3/4 Miles	West	of Hwy 3 marks

OTHER LANDMARK
Entergy Substation Hwy 3 & airport Rd.

WELL PURPOSE. Home, Irrigation, Municipal, Industrial, Fish Pond, etc.
Gardening

PUMP DATA

PUMP TYPE (Circle One): (Submersible,) Turbine, Jet Flowing Well, Other (Describe) _____

POWER TYPE (Circle One): (Electric,) Tractor, Diesel, Gasoline, Butane, Other (Describe) _____ H/P _____

Pump Capacity (GPM)	No of Stages	Setting Depth
20 GPM		60' FT.

PUMP TEST
Well yielded 20 GPM with a drawdown of 13 ft. after 5 hours of pumping

WELL DATA

Well Depth	Casing Diameter (In.)	Casing Length (Ft.)
100'	4" PVC	80'

Type of Casing	Hole Depth	Depth to Static Water Level
PVC 160	100'	23'

TYPE OF COMPLETION: (Circle One or More): (Gravel Packed,) Underreamed, Telescoped, Natural Development, Open Hole, Other (Describe) _____

WELL GROUTED TO A DEPTH OF 15 FEET
Type Grout (circle one): (Cement,) Bentonite, or Mix

LOG DATA

TYPE OF LOG RUN (Circle One): No Log Run, Electric, Gamma Ray, Density, Sonic, Neutron, Other (Describe) _____

Name of Organization Running Log

GEOLOGIC DATA (Office Use Only)

Surface Elev.	Geologic Unit	Unit Thickness	Depth to Top
Subs. SWL	Date	Analysis	Aquifer Test

Driller's Remarks

Top of Lap Pipe or Reduction in Casing
FEET — IF TELESCOPED OR MORE THAN ONE SCREEN: USE BACK PAGE

SCREEN DATA

Diameter - Inches	Length - Feet	Slot Size - Inches
4"	2-10' pcs	.011

Screen Type	Depth to Bottom - Feet
Sch 40	80'-100'

DESCRIPTION OF FORMATIONS ENCOUNTERED	FROM	TO	FORMATIONS (Continued)	FROM	TO
Clay & Sand	0	20			
Sand & gravel	20	40			
gravel	40	60			
gravel	60	80			
gravel	80	100			
			IF MORE SPACE IS NEEDED, USE BACK		

REC'D MAY 21 2001

If well telescopes please
sketch and show depths.

GROUND LEVEL

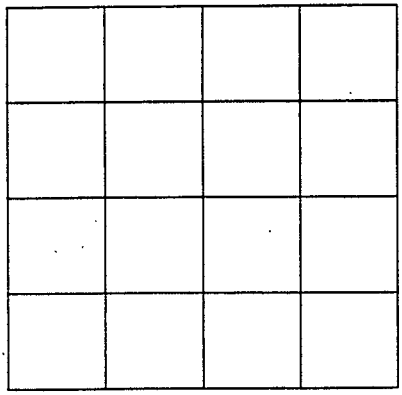

SECTION _____

Please indicate well location X.

ADDITIONAL INFORMATION

If more than one screen,
show location of each on sketch.