


QUILMAN

K 36
4-2-64

WATER WELL DRILLERS LOG

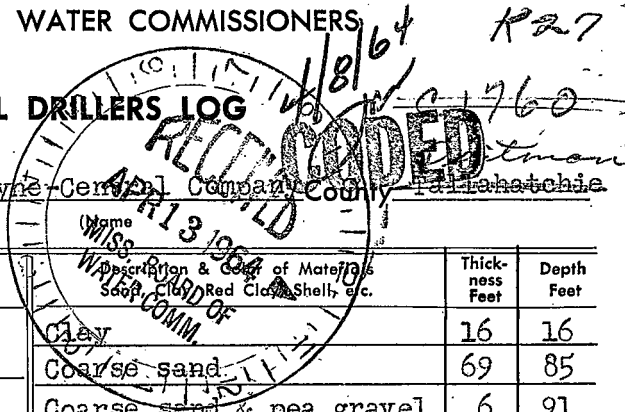

Date: April 2, 1964, Driller: Layne-Central Company, County: Tallahatchie

(1) Owner of Land: Yandell Brothers
(Name)
Vance, Mississippi
(Address)

(2) Location: 1/4, 1/4, Sec. 36 T26N
2W
_____ miles _____ of Vance
(distance) (direction) (Nearest Town)

(3) Topography: flat
(Hilly) (Flat) (Level)

(4) Purpose of Well: domestic
(Domestic Irrigation
Municipal, Industrial, Other)

Description & Color of Materials Sand, Clay, Red Clay, Shells, etc.	Thick- ness Feet	Depth Feet
Clay	16	16
Coarse sand	69	85
Coarse sand & pea gravel	6	91
Clay	23	114
Fine sand & clay strks.	75	189
Clay	30	219
Clay & sandy clay strks.	14	233
Sand rock	2	235
Clay	18	253
Sand & clay strks.	164	417
Shale	22	439
Rock	1	440
Sandy shale	7	447
Hard rock	1	448
Sandy shale	22	470
Hard rock	2	472
Hard shale	18	490
Sandy shale	20'	510
Hard shale	18	528
Shale with sandy shale		
strks.	65	593
Shale & fine sand strks.	33	626
Hard shale	36	662
Sandy shale	13	675
Hard shale	18	693
Clay with sandy clay		
strks.	58	751
Hard clay	47	798
Fine sand	22	820
Sand	41	861
Clay	5	866

Information upon completion of well:

(1) Diameter 1x3 inches.

(2) Total Depth 866 feet.

(3) Water Level flowing feet below top of ground.

(4) Cased to 103', Size 1 1/2 casing
724' 3"

(5) Screen: Size 3", Length 31'

(6) Were any formations sealed against pollution?
yes yes, _____ no.

If YES depth of formation Sealed with pack
packer.

Why _____

Drillers Remarks: _____

(Use Back Side)

Well No.







