L47
Quitman
7-15-84

MISSISSIPPI DEPARTMENT OF NATURAL RESOURCES

Bureau of Land and Water Resources
Southport Mall
P.O. Box 10631
Jackson, Mississippi 39209

CODED

WATER WELL DRILLERS LOG

7/84 19 — Powell Irrigation — Quitman

date well completed — firm name — county well located

LANDOWNER: E Q Vance

(mailing address)

WELL LOCATION:

sec. 31 T 26 N/S R 1 E/W

2 (distance) miles NE (direction) of Vance (nearest town)

WELL PURPOSE: Irrigation (home, irrigation, municipal, industrial)

WELL COMPLETION DATA:

(1) diameter (inches) 12

(2) total depth (feet) 100

(3) static water level (feet) 15 below/above top of ground.

(4) casing Steel (material), 60 (depth),

_____ (size) if telescope see back.

(5) screen 40 (length), 60 (depth to top)

12 (size), Steel (material)

(6) pump 30 (HP) 1500 (yield gpm)

Diesel (type power)

(7) electric log NO (yes or no)

_____ (organization running log)

(8) how well bottom plugged Steel Plate

DRILLERS REMARKS:

description of formations encountered	from	to
Clay	0	10
Med & Coarse Sand	10	40
Coarse Sand & Gravel	40	100

DEPT. OF NATURAL RESOURCES
BUREAU OF LAND & WATER RESOURCES
NOV 29 1984
RECEIVED

If well telescopes please sketch and show depths.

GROUND LEVEL

If more than one screen, show locations of each on sketch.

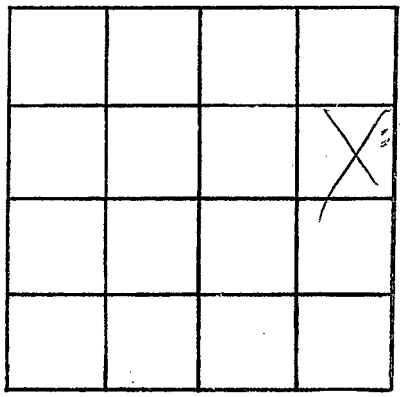

SECTION 31

Please indicate well location X.

ADDITIONAL INFORMATION