# MISSISSIPPI DEPARTMENT OF NATURAL RESOURCES

Bureau of Land and Water Resources

P.O. Box 10631
Jackson, Mississippi 39209

WATER WELL DRILLERS LOG

CODED

| | |
|---|---|
| COUNTY WELL LOCATED | Quitman |
| WELL NUMBER | L 51 |
| CODED | |
| PERMIT NUMBER | |
| NAME OF DRILLING FIRM | Fo well Inc, Inc Rt 2 Box 280 Clarksdale MS 38614 |
| DATE WELL COMPLETED | 7-8-8 |

NAME & MAILING ADDRESS OF LANDOWNER: Hubert H. Haynes, RT 1, Box 208, Lambert, MS 38643

WELL LOCATION: SEC 3 TOWNSHIP 26 N RANGE 1 W

DISTANCE 5 Miles DIRECTION SE NEAREST TOWN Lambert

OTHER LANDMARK

WELL PURPOSE: Home, Irrigation, Municipal, Industrial, Fish Pond, etc.

## PUMP DATA

PUMP TYPE (Circle One): Submersible, Turbine, Jet, Flowing Well, Other (Describe)

POWER TYPE (Circle One): Electric, Tractor, Diesel, Gasoline, Butane, Other (Describe)

| Pump Capacity (GPM) | No. of Stages | Setting Depth |
|---|---|---|
| 1500 | 2 | 50 FT. |

PUMP TEST

Well yielded 1,500 GPM with a drawdown of _____ ft. after _____ hours of pumping

## WELL DATA

| Well Depth | Casing Diameter (In.) | Casing Length (Ft.) |
|---|---|---|
| 100' | 12" | 60' |
| **Type of Casing** | **Hole Depth** | **Depth to Static Water Level** |
| Steel | 100' | 18' |

TYPE OF COMPLETION: (Circle One or More): Gravel Packed, Underreamed, Telescoped, Natural Development, Open Hole, Other (Describe)

Top of Lap Pipe or Reduction in Casing FEET

IF TELESCOPED OR MORE THAN ONE SCREEN: USE BACK PAGE

## LOG DATA

TYPE OF LOG RUN (Circle One): No Log Run, Electric, Gamma Ray, Density, Sonic, Neutron, Other (Describe)

Name of Organization Running Log

## GEOLOGIC DATA (Office Use Only)

| Surface Elev. | Geologic Unit | Unit Thickness | Depth to Top |
|---|---|---|---|
| Subs. SWL | Date | Analysis | Aquifer Test |

Driller's Remarks

## SCREEN DATA

| Diameter - Inches | Length - Feet | Slot Size - Inches |
|---|---|---|
| 12" | 40 | .030 |
| **Screen Type** | **Depth to Bottom - Feet** | |
| Steel | 100' | |

| DESCRIPTION OF FORMATIONS ENCOUNTERED | FROM | TO |
|---|---|---|
| Clay | 0 | 20 |
| Fine Sand | 20 | 40 |
| Coarse Sand & gravel | 40 | 100 |

| FORMATIONS (Continued) | FROM | TO |
|---|---|---|
| | | |

IF MORE SPACE IS NEEDED, USE BACK

RECEIVED
SEP 22 1988
Department of Natural Resources
Bureau of Land & Water Resources

If well telescopes please
sketch and show depths.

GROUND LEVEL

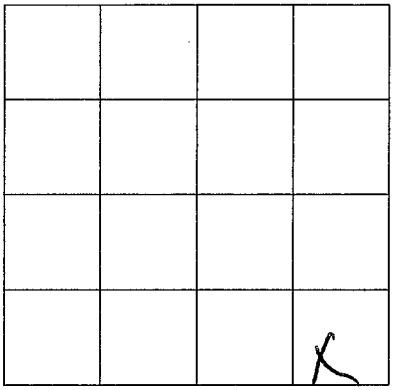


SECTION 3

Please indicate well location X.

ADDITIONAL INFORMATION

If more than one screen,
show location of each on sketch.