


RANKIN
F37
6-12-61

WATER WELL DRILLERS LOG **CODED**

Date: 6/12, 1961, Driller: Johnnie Beasley County: Rankin
(Name)

	Description & Color of Materials Sand, Clay, Red Clay, Shell, etc.	Thick- ness Feet	Depth Feet
(1) Owner of Land: <u>Ernest Inter</u> (Name)			
<u>Hwy. 80 West, Jackson, Miss.</u> (Address)	Yellow clay.		0-36
This well is located on <u>above</u> Flow- ood <u>road</u> to <u>Hearl</u> river dam. <u>R.</u> (2) Location: <u>14-6-2</u>	Blue clay.		36-327
<u>8 miles North</u> of <u>Flowood</u> (distance) (direction) (Nearest Town)	Shale.		327-365
(3) Topography: <u>x</u> (Hilly) (Flat) (Level)	Silt.		365-369
(4) Purpose of Well: <u>Domestic</u> (Domestic Irrigation Municipal, Industrial, Other)	Rock.		369-371
Information upon completion of well:	Lime, shell & shale.		371-410
(1) Diameter <u>4 1/2</u> inches.	Shale & stks. silt.		410-570
(2) Total Depth <u>656</u> feet.	Fine sand & stks. shale.		570-586
(3) Water Level <u>115'</u> feet below top of ground. <u>250'</u> of <u>4"</u>	Fine sand.		586-600
(4) Cased to <u>631'</u> , Size <u>406'</u> of <u>2"</u>	Sand. (Screen setting)		600-656
(5) Screen: Size <u>2"</u> , Length <u>25'</u>			
(6) Were any formations sealed against pollution? <u>yes</u> , <u>x</u> no.			
If YES depth of formation _____			
Why _____			
Drillers Remarks: <u>Good well.</u>			

CODED

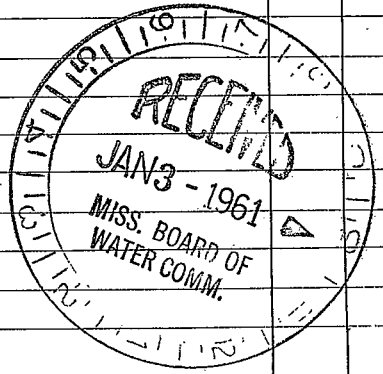

(Use Back Side)

Well No.

Retain this copy for your office files.








