RANKIN
Q51
10-13-73
Log # 389

MISSISSIPPI
BOARD OF WATER COMMISSIONERS
416 North State Street
Jackson, Mississippi 39201

CODED

WATER WELL DRILLERS LOG

10/13 1973 Singer Layne Central Div Rankin
date well completed — firm name — county well located

LANDOWNER: Thomasville Water Assoc.
Brandon, Miss
(mailing address)

WELL LOCATION:
sec. 20 T 4 N R 3 E

miles (distance) (direction) of (nearest town)

WELL PURPOSE: Domestic
(home, irrigation, municipal, industrial)

WELL COMPLETION DATA:

(1) diameter (inches) 10"
(2) total depth (feet) 992'
(3) static water level (feet) 156' below above top of ground.
(4) casing Steel (material), 920' (depth),
10" (size) + 60' of 6" if telescope see back.
(5) screen 58' (length), 920' (depth to top)
6" (size), Stainless Steel W.W. (material)
(6) pump 20 (HP) 125 (yield gpm)
Electric (type power)
(7) electric log Yes (yes or no)
Miss. Geo. Survey (organization running log)
(8) how well bottom plugged Valve

DRILLERS REMARKS:

description of formations encountered	from	to
Red Sandy Clay	0	8
Sand	8	22
Lime	22	36
Sandy Clay	36	80
Clay & Sand Streaks	80	159
Rock	159	162
Clay	162	165
Hard Lime Rock	165	183
Clay	183	466
Hard Shale	466	527
Sandy Clay	527	650
Clay	650	687
Rock	687	689
Sandy Clay	689	806
Shale and Sand Streaks	806	854
Sand	854	953
Clay, Sand Streaks	953	970
Clay	970	994

CODED

OCT 18 1973
MISS. BD. OF WATER COMMISSIONERS

If well telescopes please sketch and show depths.

GROUND LEVEL

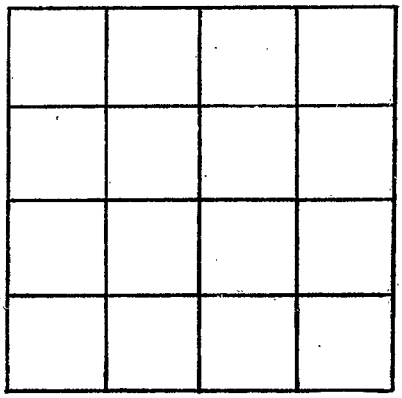

SECTION _____

Please indicate well location X.

ADDITIONAL INFORMATION

If more than one screen, show locations of each on sketch.