

RANKIN MISSISSIPPI BOARD OF WATER COMMISSIONERS

W26
2-12-64

WATER WELL DRILLERS LOG

CODED

Date: Feb 12, 19 64, Driller: W. G. Butler County Smith
(Name)

(1) Owner of Land: Bobby Fortenbury
(Name)
Mendenhall Miss
(Address)

(2) Location: 1/4, 1/4, Sec. 29 T8 R4E
8 miles South, of Jacks
(distance) (direction) (Nearest Town)

(3) Topography: (Level)
(Hilly) (Flat)

(4) Purpose of Well: Domestic
(Domestic, Irrigation, Municipal, Industrial, Other)

Description & Color of Materials Sand, Clay, Red Clay, Shell, etc.	Thick- ness Feet	Depth Feet
Chalk	1-	6
Rock	6-	14.0
Rock + Chalk	40-	50
Rock	50-	60
Rock + Sand	60-	70
Sand	70-	90
Chalk + Rock	90-	110
Rock - Chalk + Limestone	110-	120
Shell + Rock	120-	130
Chalk + Shell	130-	148
Sand	148-	160
Chalk	160-	168

Information upon completion of well:

(1) Diameter 2 inches.

(2) Total Depth 168 feet.

(3) Water Level 85 feet below top of ground.

(4) Cased to 150, Size 2"


(5) Screen: Size 2", Length 10'

(6) Were any formations sealed against pollution?
_____ yes, _____ no.

If YES depth of formation _____

Why _____

Drillers Remarks: _____

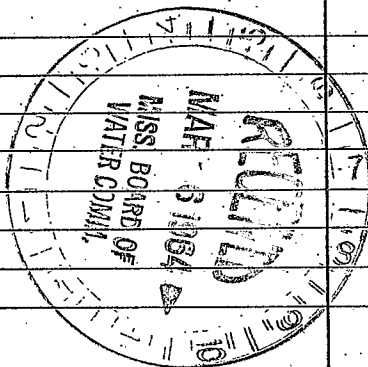

(Use Back Side)

Well No.






