

RANKIN MISSISSIPPI BOARD OF WATER COMMISSIONERS

X 58
9-3-63

WATER WELL DRILLERS LOG

CODED

Date: Sept. 3, 1963, Driller: W. G. Butler County Smith
(Name)

- (1) Owner of Land: Epiphial McFarlan
(Name)
Brandons Rte. Miss
(Address)
- (2) Location: 1/4, 1/4, Sec. 15 T3R5E4
3 miles North, of Puckett
(distance) (direction) (Nearest Town)
- (3) Topography: (Hilly) (Flat) (Level)
- (4) Purpose of Well: Domestic
(Domestic Irrigation
Municipal, Industrial, Other)

Description & Color of Materials Sand, Clay, Red Clay, Shell, etc.	Thick- ness Feet	Depth Feet
Red Clay	1-	5
Sand	5-	10
Chalk	10-	15
Red Sand	15-	20
Sand + Chalk	20-	30
Sand	30-	40
Sand + Chalk	40-	57
Sand	57-	70

Information upon completion of well:


- (1) Diameter 2 inches.
- (2) Total Depth 90 feet.
- (3) Water Level 60 feet below top of ground.
- (4) Cased to 85, Size 2
- (5) Screen: Size 2", Length 5'
- (6) Were any formations sealed against pollution?
_____ yes, _____ no.

If YES depth of formation _____

Why _____

Drillers Remarks: _____

CODED

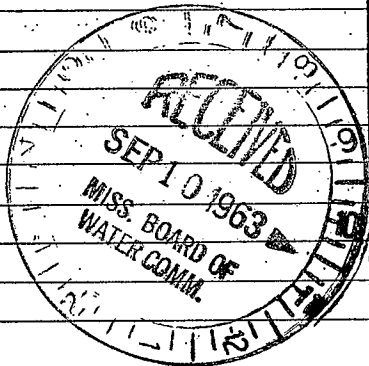

(Use Back Side)

Well No.





















