

SCOTT

WATER WELL DRILLERS LOG

3 E 3
8-8-62

Date: Aug 8, 1962, Driller: Roy Wilkerson County _____
(Name)

(1) Owner of Land: B. C. Rogers
(Name)

Morton Miss
(Address)

(2) Location: _____ 1/4, _____ 1/4, Sec. 14 T. 7N R. 6E

1/4 miles S of Forkville
(distance) (direction) (Nearest Town)

(3) Topography: Level
(Hilly) (Flat) (Level)

(4) Purpose of Well: Domestic
(Domestic Irrigation
Municipal, Industrial, Other)

Description & Color of Materials Sand, Clay, Red Clay, Shell, etc.	Thick- ness Feet	Depth Feet
<u>Red sand</u>	<u>5</u>	
<u>yellow clay</u>	<u>30</u>	
<u>Sandy silt</u>	<u>174</u>	
<u>Rocky</u>	<u>10</u>	
<u>Water band</u>	<u>60</u>	

Information upon completion of well:

(1) Diameter 2 inches.

(2) Total Depth 279 feet.

(3) Water Level 90 feet below top of ground.

(4) Cased to 279', Size 2"

(5) Screen: Size 2", Length 6'


(6) Were any formations sealed against pollution?

_____ yes, _____ no.

If YES depth of formation _____

Why _____

Drillers Remarks: _____

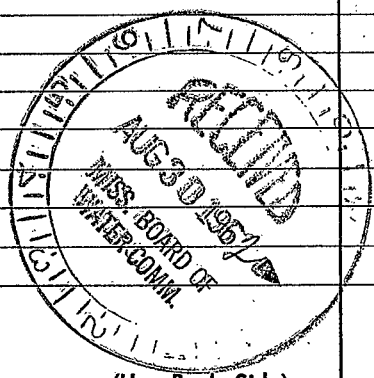

(Use Back Side)

Well No.








