

SCOTT MISSISSIPPI BOARD OF WATER COMMISSIONERS

5 G14
8-10-65

WATER WELL DRILLERS LOG

Date: 8/10, 1965, Driller: Forest Drilling Ser County: Scott
(Name)

(1) Owner of Land: Benton Dixon
(Name)
Hillsboro, Miss.
(Address)

(2) Location: 1/4, 1/4, Sec. 11 T. 11 N. R. 5
5 1/2 miles N. East of Forest
(distance) (direction) (Nearest Town)
at Hillsboro

(3) Topography: Hilly (Hilly) (Flat) (Level)

(4) Purpose of Well: Chickens
(Domestic Irrigation
Municipal, Industrial, Other)

Description & Color of Materials Sand, Clay, Red Clay, Shell, etc.	Thick- ness Feet	Depth Feet
<u>Brown Clay</u>	<u>0</u>	<u>15</u>
<u>dry sand + clay</u>		<u>22</u>
<u>Clay</u>		<u>82</u>
<u>Clay + Shs. Sand</u>		<u>152</u>
<u>Clay</u>		<u>162</u>
<u>Clay + Shs. Sand</u>		<u>192</u>
<u>F. Sand + sh. Clay</u>		<u>192</u>
<u>Fine Sand</u>		<u>212</u>
<u>Fine Sand</u>		<u>222</u>
<u>Good Sand</u>		<u>241</u>

Information upon completion of well:

(1) Diameter 2 inches.

(2) Total Depth 241 feet.


(3) Water Level 70 feet below top of ground.

(4) Cased to 231, Size 2"

(5) Screen: Size 2", Length 10ft.

(6) Were any formations sealed against pollution?
 yes, no.

If YES depth of formation _____
 Why _____
 Drillers Remarks: _____

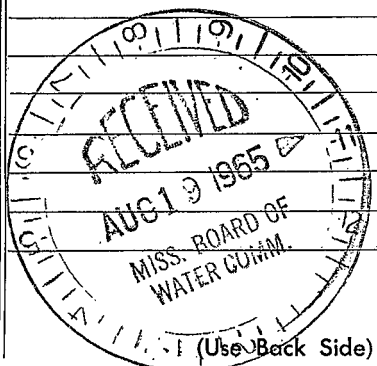

Well No. _____




