

SCOTT MISSISSIPPI BOARD OF WATER COMMISSIONERS

G 30


10-16-63 CODED

WATER WELL DRILLERS LOG

Date: 10/16, 1963, Driller: Frank Perry Sr County Scott
 (Name)

(1) Owner of Land: <u>Nath Bennett High School</u> (Name)	Description & Color of Materials Sand, Clay, Red Clay, Shell, etc.	Thick-ness Feet	Depth Feet
<u>Forest, Miss St High</u> (Address)	<u>Brown Clay</u>	<u>0</u>	<u>20</u>
(2) Location: <u>NE 1/4, NE 1/4, Sec 10, T 10 N, R 8 E</u> <u>6</u> miles <u>North</u> , of <u>Forest</u> (distance) (direction) (Nearest Town)	<u>Clay</u>		<u>61</u>
	<u>Sand & Clay</u>		<u>100</u>
	<u>Fine Sand</u>		<u>121</u>
	<u>Fine Sand & Shale</u>		<u>140</u>
	<u>Fine Sand</u>		<u>180</u>
(3) Topography: <u>X</u> (Hilly) (Flat) (Level)	<u>Clay</u>		<u>204</u>
	<u>Shale & Sh. Rock</u>		<u>225</u>
(4) Purpose of Well: <u>School</u> (Domestic Irrigation, Municipal, Industrial, Other)	<u>Clay & Sh. Shell</u>		<u>245</u>
	<u>Shale</u>		<u>270</u>
	<u>Shale & Rock</u>		<u>286</u>
	<u>Fine Sand</u>		<u>307</u>
	<u>Fin Sand</u>		<u>347</u>
			<u>347-350</u>
Information upon completion of well:			
(1) Diameter <u>4</u> inches.	<u>Well drilled</u>		<u>350</u>
(2) Total Depth <u>347</u> feet.	<u>Screen</u>		<u>307-347</u>
(3) Water Level <u>120</u> feet below top of ground.	<u>20' of .008</u>		
(4) Cased to <u>307</u> , Size <u>4"</u>	<u>10' of .010</u>		
(5) Screen: Size <u>30' 3 3/4" .008 #10</u> , Length <u>30'</u>			
(6) Were any formations sealed against pollution? _____ yes, _____ no.			
If YES depth of formation _____			
Why _____			
Drillers Remarks: <u>Setting 160'</u> <u>7 1/2 HP</u> <u>2500 gal tank</u>			

CODED

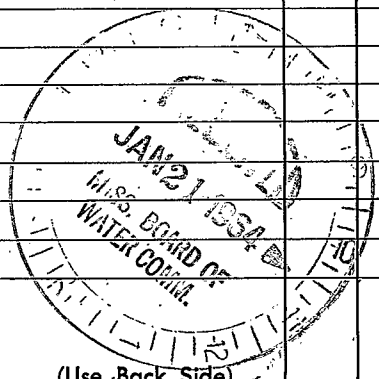

(Use Back Side)

Well No.




