Scott
G44
12-30-67

MISSISSIPPI
BOARD OF WATER COMMISSIONERS
416 North State Street
Jackson, Mississippi 39201

CODED

WATER WELL DRILLERS LOG

12-30 1967 Cameron Drilling Co. Scott
date well completed — firm name — county well located

LANDOWNER Cliff Aston
P.O. Box 5 Hazlehurst
Miss
(mailing address)

WELL LOCATION:
sec. 17 T 7 N/S R 8 E/W
4 (distance) miles 5 (direction) of Hazlehurst (nearest town)

WELL PURPOSE: Home
(home, irrigation, municipal, industrial)

WELL COMPLETION DATA:
(1) diameter (inches) 2"
(2) total depth (feet) 66
(3) static water level (feet) 45 below above top of ground.
(4) casing Steel (material), 63 (depth), ____ (size) if telescope see back.
(5) screen 3 (length), 63 (depth to top), 1W (size), SS (material)
(6) pump 1/2 (HP) 260 (yield gpm) ____ (type power)
(7) electric log X (yes or no) ____ (organization running log)
(8) how well bottom plugged B Wash

DRILLERS REMARKS:

description of formations encountered	from	to
Clay	0	8
Red Sand, Very Fine	8	13
Dark Clay	13	48
Sand Becoming Coarse With Depth	48	66

CODED

FEB 1 8 1969
MISS. BD. OF WATER COMM.

If well telescopes please sketch and show depths.

GROUND LEVEL

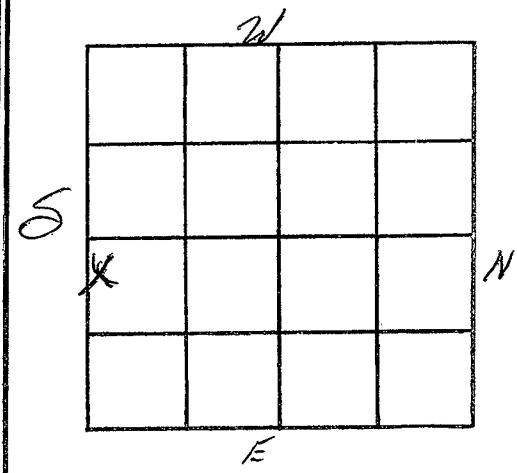

SECTION 10

Please indicate well location X.

ADDITIONAL INFORMATION

If more than one screen, show locations of each on sketch.