SCOTT
L35
Elog 115

MISSISSIPPI
BOARD OF WATER COMMISSIONERS
416 North State Street
Jackson, Mississippi 39201

CODE

WATER WELL DRILLERS LOG

8-29 1973 Singer-Layne Central Div. Scott
date well completed — firm name — county well located

LANDOWNER: City of Forest
Forest, Miss.
(mailing address)

WELL LOCATION:
sec. 28 T 6 N R 8 E

_____ miles _____ of _____
(distance) (direction) (nearest town)

WELL PURPOSE: Municipal
(home, irrigation, municipal, industrial)

WELL COMPLETION DATA:

(1) diameter (inches) 16"

(2) total depth (feet) 1303'

(3) static water level (feet) 194' below ~~above~~ top of ground.

(4) casing Steel (material), 1236' (depth),
16" (size) 64'8"
if telescope see back.

(5) screen 60' (length), 1236' (depth to top)
8" (size), Stainless Steel (material)

(6) pump 125 (HP) 700 (yield gpm)
Electric (type power)

(7) electric log yes (yes or no)
U.S.G.S. (organization running log)

(8) how well bottom plugged Valve

DRILLERS REMARKS:

description of formations encountered	from	to
Red Clay (Brittle)	0	33
Blue Clay	33	177
Sandy Clay	177	240
Sand and Clay Streaks	240	400
Shale	400	481
Rock	481	483
Shale w/ Hard Streaks	483	520
Sandy Shale	520	550
Sand & Shale Breaks	550	798
Shale	798	836
Rock	836	838
Shale	838	983
Rock	983	985
Shale & Streaks of Rock	985	1182
Sandy Shale	1182	1249
Sand & Shale Breaks	1249	1315
Shale	1315	1340

125
6

SEP 7 1973
MISS. BD. OF
WATER COMM.

If well telescopes please sketch and show depths.

GROUND LEVEL

If more than one screen, show locations of each on sketch.

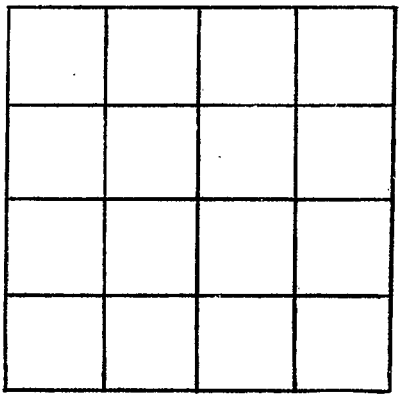

SECTION _____

Please indicate well location X.

ADDITIONAL INFORMATION