

NEWTON

MISSISSIPPI BOARD OF WATER COMMISSIONERS

WATER WELL DRILLERS LOG

J  
1-5-63

5 M38

SCOTT  
NEWTON

Date: 1-5, 1963, Driller: LEACH

County: NEWTON

(Name)

(1) Owner of Land: JAMES TADLOCK  
(Name)  
LAKE MISS.  
(Address)

Description & Color of Materials Sand, Clay, Red Clay, Shell, etc.	Thick- ness Feet	Depth Feet
Blue Clay	75	
Clay + Sand	80	155
SAND	103	258

(2) Location: 1/4, 1/4, Sec. 25 T. R. 42  
1/2 miles S, of LAKE  
(distance) (direction) (Nearest Town)

(3) Topography: Level  
(Hilly) (Flat) (Level)

(4) Purpose of Well: DOMESTIC  
(Domestic Irrigation  
Municipal, Industrial, Other)


Information upon completion of well:

- (1) Diameter 2" inches.
- (2) Total Depth 258 feet.
- (3) Water Level 100 feet below top of ground.
- (4) Cased to 258, Size 2"
- (5) Screen: Size 2", Length 6"
- (6) Were any formations sealed against pollution?  
yes, no.

If YES depth of formation 100 ft

Why

Drillers Remarks:

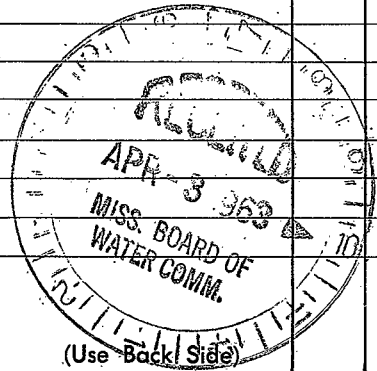

4

Well No.

(Use Back Side)





