Scott
M42
11-68

CODED CODED CODED Coby

MISSISSIPPI
BOARD OF WATER COMMISSIONERS
416 North State Street
Jackson, Mississippi 39201

WATER WELL DRILLERS LOG

Nov 19 68 Wilkerson Drilling Scott
date well completed — firm name — county well located

LANDOWNER: Taylor Bros.
Station: Lake, Miss
(mailing address)

WELL LOCATION:
sec. 16 T 6 N S R 9 E W
4½ miles west of Lake
(distance) (direction) (nearest town)

WELL PURPOSE: home
(home, irrigation, municipal, industrial)

WELL COMPLETION DATA:

(1) diameter (inches) 2
(2) total depth (feet) 173
(3) static water level (feet) 62 below above top of ground.
(4) casing Galv, 168,
(material) (depth)
_____ if telescope see back.
(size)
(5) screen 5, 173
(length) (depth to top)
2, brass
(size) (material)
(6) pump 2 14
(HP) (yield gpm)
Elec
(type power)
(7) electric log No
(yes or no)
_____
(organization running log)
(8) how well bottom plugged 2" Bulk

DRILLERS REMARKS:

description of formations encountered	from	to
Yellow Clay	0	10
Yellow Clay + Rock	10	35
Blue Clay	35	85
Rock	85	88
brown clay	88	105
SAND	105	173

DEC 5 1968
MISS. BD. OF WATER COMM.

If well telescopes please sketch and show depths.

GROUND LEVEL

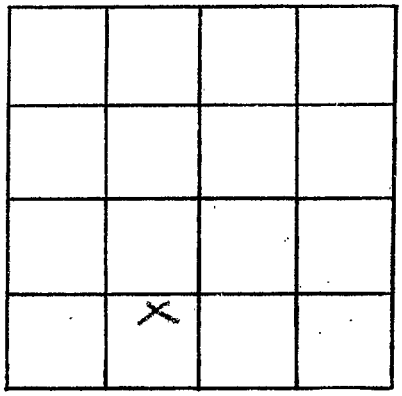

SECTION 16

Please indicate well location X.

ADDITIONAL INFORMATION

If more than one screen, show locations of each on sketch.