

4 P 15  
10-7-64

WATER WELL DRILLERS LOG

Date: 10/7, 1964, Driller: Forest Drilling Se County Scott  
(Name)


- (1) Owner of Land: Radde + Radde  
(Name)  
Rt 2 Forest, Miss  
(Address)
- (2) Location: 1/4, 1/4, Sec. 31 T R  
12 miles South of Forest  
(distance) (direction) (Nearest Town)
- (3) Topography:  (Hilly)  (Flat)  (Level)
- (4) Purpose of Well: Chickens  
(Domestic Irrigation  
Municipal, Industrial, Other)

Description & Color of Materials Sand, Clay, Red Clay, Shell, etc.	Thick- ness Feet	Depth Feet
<u>Red Clay</u>		<u>12</u>
<u>Red Sand + Clay</u>		<u>52</u>
<u>Fine Sand +</u> <u>2 lbs Clay</u>		<u>72</u>

Information upon completion of well:

- (1) Diameter 2 inches.
- (2) Total Depth 72 feet.
- (3) Water Level 23 feet below top of ground.
- (4) Cased to 62, Size 2"
- (5) Screen: Size 2", Length 10 ft
- (6) Were any formations sealed against pollution?  
no

If YES depth of formation \_\_\_\_\_  
Why \_\_\_\_\_  
Drillers Remarks: \_\_\_\_\_

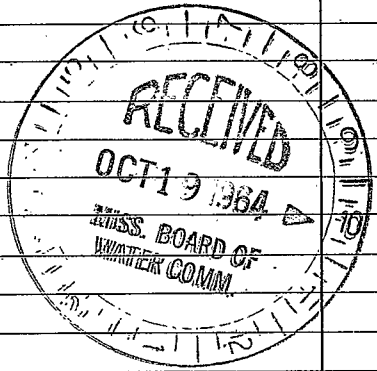

(Use Back Side)

Well No.






