

Sharkey

State Well Report

Part 1 - Driller's Log

Mississippi Department of Environmental Quality
Office of Land and Water Resources
P.O. Box 2309
Jackson, MS 39225
(601)961- 5210
(601)961- 5228 (fax)

For Office Use Only:

Aquifer: _____
Well #: A 202
L. S. Elevation: _____
E-log #: _____

County: Washington
Permit #: GW-45189-
Driller: J. NEWCOME 0.773
Date drilling completed: 11-11-11

State Law requires that this report be prepared by the license holder responsible for the work and filed with the Department at the above address within 30 days of completion of drilling of the well or borehole.

Information on Well Owner <i>(Landowner if borehole is not for a water well)</i>	Well or Borehole Location
Owner Name <u>Panther Burn Land Company</u>	Latitude: <u>33° 05' 28"</u> Longitude: <u>90° 52' 03"</u>
Mailing Address: <u>PO Box 273</u>	Method of Lat/Long (circle one): Conventional Survey,
<u>Stoneville MS 38776</u>	USGS quad <u>(Hand-held GPS)</u> Survey-grade GPS
City State Zip Code	<u>SW 1/4 NE 1/4 Sec 01 Twn 14N Rng 07W</u>
Telephone No. () _____	Distance <u>5.5</u> Miles Direction <u>S.</u> of Nearest Town <u>HOLLANDALE</u>

Well / Borehole Data

Date drilling started: 11-11-2011 Date drilling completed: 11-11-2011 Hole depth: 112 Hole diameter: 24"

Location of the source of any surface water used for drilling: DITCH

Method of dosing and volume of Chlorine used in drilling and development: CHLORINE TABLETS

Logs run (circle all applicable): (No log run) Electric Gamma Ray Density Sonic Neutron Other: _____

Name of organization running log(s): _____

Purpose of borehole (check one): Water Well Geotechnical/Geological Investigation _____ Ground Source Heat Pump _____

Seismic Survey _____ Other (describe) _____

If drilling is not related to water well construction, skip the remainder of this block

Purpose of Well (check one): Home _____ Industrial _____ Public Supply _____ Irrigation Fish Culture _____ Other: _____

If a flowing well, method of flow regulation: Valve _____ Other (describe) _____

Static Water Level: _____ feet above or below (circle one) land surface Date measured: _____

Method of Measurement (circle one) steel tape electric tape air line other: _____

Well depth: 110 Well grouted to a depth of 10 feet Type of grout (circle one): Neat Cement Bentonite Mix

Casing length: 70 feet Casing diameter: 2 1/2 inches Type of casing: P.V.C.

Screen length: 40 feet Screen diameter: 2 1/2 inches Type of screen: P.V.C.

Screen slot size: .050 inches Setting depth: From 70 feet to 110 feet

Type of completion (circle all applicable): Gravel packed Underreamed Telescoped Open hole Natural Development

Other (describe): _____

Top of lap pipe or reduction in casing: _____ feet. *If telescoped or more than one screen, describe on next page*

Form: OLWR-SWR-1A (04/08)

RECEIVED

MAY 23 2012

BY: OLWR

STATE WELL REPORT

Part 2

Pump Installer's Completion Report
Mississippi Department of Environmental Quality
Office of Land and Water Resources
P.O. Box 2309
Jackson, MS 39225
(601)961-5210
(601)961-5228 (fax)

For Office Use Only:

Aquifer: _____

Well #: A202

Elevation: _____

County: Washington
Permit #: GW-45189
Driller: J. Newcome 0-773
Date completed: 11-11-11

Copy information from block on Part 1

This part of the report must be completed by a licensed water well contractor or a licensed pump installer. A copy of Part 1 of the report must be attached and both parts filed with the Department at the above address within 30 days of well completion.

Well Owner Information	Well Location
Owner Name: <u>Panther Burn Land Company</u>	Latitude: <u>33 05 28</u> Longitude: <u>90 52 03</u>
Mailing Address: <u>P.O. Box 273</u>	Method of Lat/Long (check one): Conventional Survey _____
<u>Stoneville MS 38776</u>	USGS quad <u>Hand-held GPS</u> , Survey-grade GPS _____
City State Zip Code	<u>SW 1/4 NE 1/4 Sec 01 T14N R 01W</u>
Telephone No. () _____	Distance Direction Nearest Town <u>55</u> Miles <u>S</u> of <u>Hollandale</u>

Pump Type	Power Type
Air Lift Circle one Jet Submersible	<u>Diesel Engine</u> Circle one Gasoline Engine Natural Gas
Bucket Piston <u>Turbine</u>	Electric Motor Hand Tractor PTO
Centrifugal Rotary Flowing Well	Windmill Other (specify): _____
Other (specify): _____	Horse Power Rating of Motor: <u>60</u>
Date Pump Installed: <u>3/28/12</u>	Setting Depth: <u>70</u> feet
Rated Pump Capacity: <u>2400</u> Gallons Per Minute	Number of Stages: <u>1</u>

Pump Test Data	Method of Measuring Water Level
Date Well Tested: _____	Air Line Circle one Electric Measuring Line Steel Tape
Static Water Level (A): _____ Feet Below Land Surface	Other (specify): _____
Pumping Water Level (B): _____ Feet Below Land Surface	For flowing well, measured shut in head: _____ feet
Drawdown [(B) - (A)]: _____ Feet Below Land Surface	Well yielded _____ GPM with a drawdown of _____ feet after _____ hours of pumping
Test Pumping Rate: _____ Gallons Per Minute	
Duration of Pump Test (minimum 4 hours): _____ hours	

This is for (circle one): New Well Replacement of Existing Pump Repair of Existing Pump

RECEIVED

I HEREBY CERTIFY that the above statements are true to the best of my knowledge.

Cony Rowe 0-711P
Print Name of Pump Installer and License No. (if applicable)

[Signature]
Signature of Pump Installer

MAY 23 2012

BY: OLWR


Form: OLWR-SWR-1C (07-09)

Note - pump not installed until end of March due to wet weather - sorry log is so late -




MARIS
Online Maps

Internet Mapping Framework

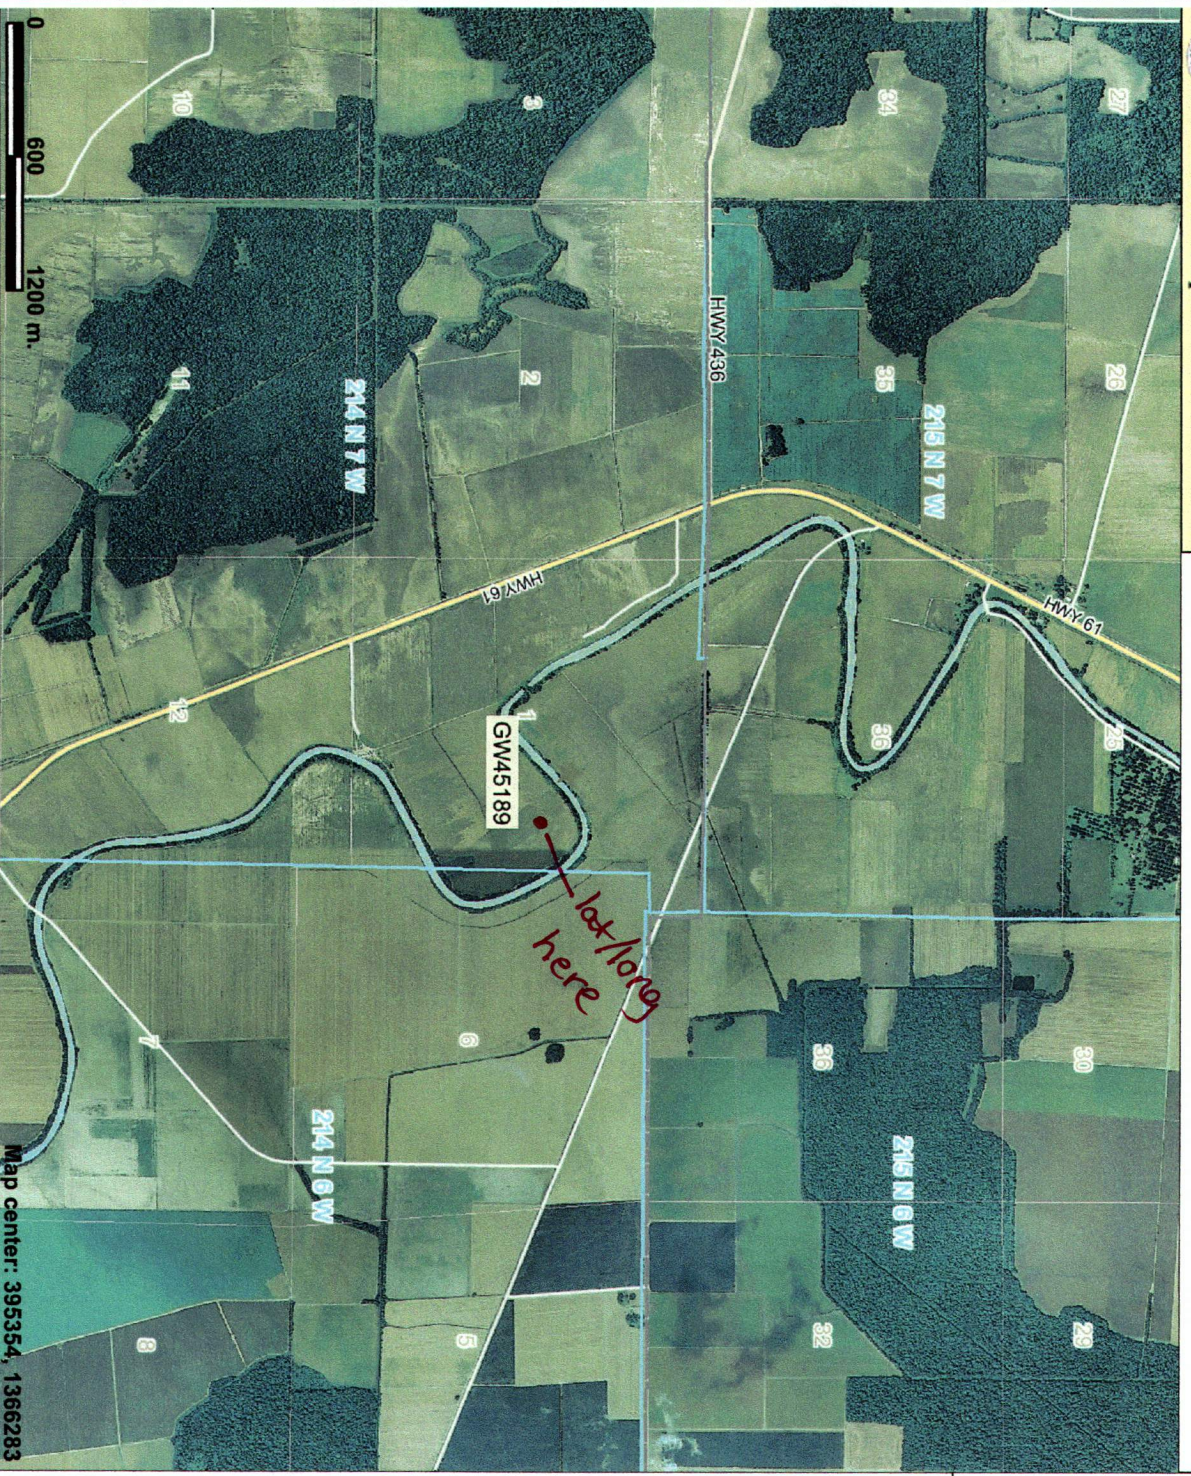

This map is a user generated static output from an Internet mapping site and is for general reference only. Data layers that appear on this map may or may not be accurate, current, or otherwise reliable. THIS MAP IS NOT TO BE USED FOR NAVIGATION.

Map center: 395354, 1366283

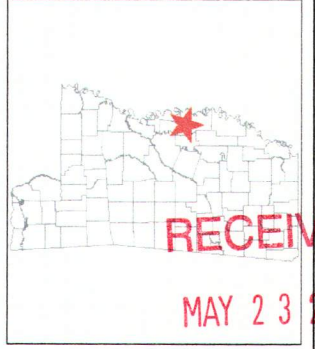

RECEIVED
MAY 23 2012
BY: OLWR

Legend

- County Boundaries
- Township
- Public Land Survey System
- MS One Call Natchez Trace Parkway
- MS One Call Interstate Highway
- MS One Call US / State Highway
- MS One Call 3 digit State Highway
- MS One Call County Roads and Streets
- Incorporated Cities
- Other Urban (non-incorporated)
- NHD Other Areas (dbl streams and inun)
- adams07_m.sid
- alcorn07_m.sid
- amite07_m.sid
- attala07_m.sid
- benton07
- bolivar07_m.sid
- calhoun07_m.sid
- carroll07_m.sid
- chickasaw07_m.sid
- choctaw07_m.sid
- claborn07_m.sid
- clarke07_m.sid



Scale: 1:32,889

