

State Well Report

Part 1 - Driller's Log

Mississippi Department of Environmental Quality
Office of Land and Water Resources
P.O. Box 2309
Jackson, MS 39225
(601)961- 5210
(601)961- 5228 (fax)

County: Sharkey
Permit #: GW-43910-
Driller: J. NEWCOME O-773
Date drilling completed: 4.13.2012

For Office Use Only:
Aquifer: _____
Well #: A 204
L. S. Elevation: _____
E-log #: _____

State Law requires that this report be prepared by the license holder responsible for the work and filed with the Department at the above address within 30 days of completion of drilling of the well or borehole.

Information on Well Owner <i>(Landowner if borehole is not for a water well)</i>	Well or Borehole Location
Owner Name: <u>Delta Pine Land Co LP</u>	Latitude: <u>33° 00' 40"</u> Longitude: <u>90° 45' 47"</u>
Mailing Address: <u>P.O. Box 5669</u>	Method of Lat/Long (circle one): Conventional Survey,
<u>Greenville</u> MS <u>38704</u>	USGS quad <u>Hand-held GPS</u> , Survey-grade GPS
City State Zip Code	<u>NE</u> 1/4 <u>SE</u> 1/4 Sec <u>36</u> Twn <u>14N</u> Rng <u>06W</u>
Telephone No. () _____	SE Distance <u>4.2</u> Miles Direction <u>N.E.</u> of Nearest Town <u>ANGUILLA</u>

Well / Borehole Data

Date drilling started: 4.13.12 Date drilling completed: 4.13.12 Hole depth: 112 Hole diameter: 24"

Location of the source of any surface water used for drilling: _____
Method of dosing and volume of Chlorine used in drilling and development: _____

Logs run (circle all applicable): No log run Electric Gamma Ray Density Sonic Neutron Other: _____
Name of organization running log(s): _____

Purpose of borehole (check one): Water Well Geotechnical/Geological Investigation ___ Ground Source Heat Pump ___
Seismic Survey ___ Other (describe) _____

If drilling is not related to water well construction, skip the remainder of this block

Purpose of Well (check one): Home ___ Industrial ___ Public Supply ___ Irrigation Fish Culture ___ Other: _____

If a flowing well, method of flow regulation: Valve ___ Other (describe) _____

Static Water Level: _____ feet above or below (circle one) land surface Date measured: _____

Method of Measurement (circle one) steel tape electric tape air line other: _____

Well depth: 110 Well grouted to a depth of 10 feet Type of grout (circle one): Neat Cement Bentonite Mix

Casing length: 70 feet Casing diameter: 16 inches Type of casing: P.V.C.

Screen length: 40 feet Screen diameter: 16 inches Type of screen: P.V.C.

Screen slot size: .050 inches Setting depth: From 70 feet to 110 feet

Type of completion (circle all applicable): Gravel packed Underreamed Telescoped Open hole Natural Development
Other (describe): _____

Top of lap pipe or reduction in casing: _____ feet. ***If telescoped or more than one screen, describe on next page***


Form: OLWR-SWR-1A (04/08)

RECEIVED
MAY 23 2012
BY: OLWR

A204

The sketch below only required for water wells

If well telescopes, show depths on sketch.

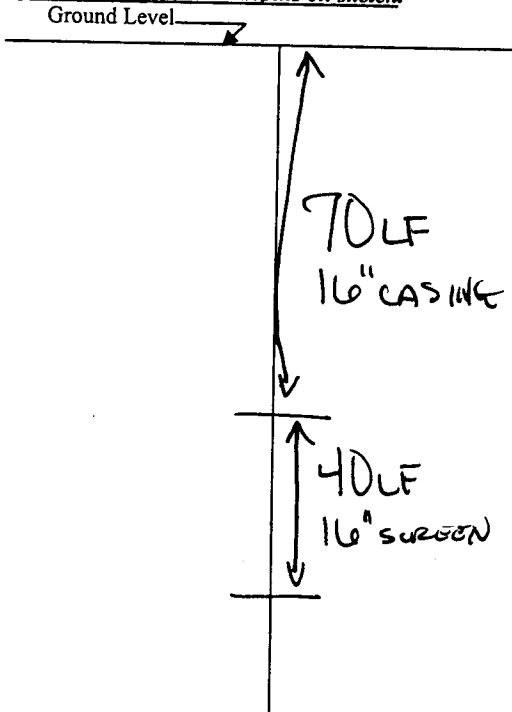

Description of formations encountered must be provided for all wells and boreholes, unless specifically exempted by regulations

Description of Formations Encountered	From (depth)	To (depth)
TOP SOIL	Ground Level	10
CLAY	10	25
FINE SAND / CLAY STRIPS	25	35
MED. SAND	35	45
MED. / COARSE SAND	45	55
COARSE SAND / PEBBLES	55	110
BOTTOM	110	112

If more than one screen, show location of each on sketch

Sketch the property layout and include the following: 1) the well location; 2) any permanent structures on the property that may aid in locating the well; 3) any roads, power lines, or other items that may aid in locating the property and the well; 4) a north arrow.

SEE MAP

Landowner Name: _____

Form: OLWR-SWR-1A (04/08)

I certify that the well/borehole was drilled, constructed, and completed in accordance with all applicable requirements of the Mississippi Department of Environmental Quality and the Mississippi Department of Health regulations, if applicable, and state laws.

JOHN NEWCOME 0-773 4.13.2012 [Signature]
 Print Name of Responsible Licensee and License No. Date Signature of Licensee

STATE WELL REPORT

Part 2

Pump Installer's Completion Report
 Mississippi Department of Environmental Quality
 Office of Land and Water Resources
 P.O. Box 2309
 Jackson, MS 39225
 (601)961-5210
 (601)961-5228 (fax)

For Office Use Only:

Aquifer: _____
 Well #: A204
 Elevation: _____

County: Shankley
 Permit #: GW-43910
 Driller: J. Newcome 0-773
 Date completed: 4.13.2012

Copy information from block on Part 1

This part of the report must be completed by a licensed water well contractor or a licensed pump installer. A copy of Part 1 of the report must be attached and both parts filed with the Department at the above address within 30 days of well completion.

Well Owner Information	Well Location
Owner Name: <u>Delta Pine Land Co. LP</u>	Latitude: <u>33 00 40</u> Longitude: <u>90 45 47</u>
Mailing Address: <u>PO Box 5669</u>	Method of Lat/Long (check one): Conventional Survey _____
<u>Greenville MS 38704</u>	USGS quad _____, Hand-held GPS <input checked="" type="checkbox"/> , Survey-grade GPS _____
City State Zip Code	<u>NE</u> ¼ <u>SE</u> ¼ Sec <u>36</u> T <u>14N</u> R <u>06W</u>
Telephone No. () _____	Distance <u>4.2</u> Miles Direction <u>NE</u> of Nearest Town <u>Anguilla</u>

Pump Type Circle one	Power Type Circle one
Air Lift <input type="checkbox"/> Jet <input type="checkbox"/> Submersible <input type="checkbox"/>	<input checked="" type="checkbox"/> Diesel Engine <input type="checkbox"/> Gasoline Engine <input type="checkbox"/> Natural Gas
Bucket <input type="checkbox"/> Piston <input type="checkbox"/> <input checked="" type="checkbox"/> Turbine	Electric Motor <input type="checkbox"/> Hand <input type="checkbox"/> Tractor PTO
Centrifugal <input type="checkbox"/> Rotary <input type="checkbox"/> Flowing Well <input type="checkbox"/>	Windmill <input type="checkbox"/> Other (specify): _____
Other (specify): _____	Horse Power Rating of Motor: <u>60</u>
Date Pump Installed: <u>4/26/12</u>	Setting Depth: <u>60</u> feet
Rated Pump Capacity: <u>2800</u> Gallons Per Minute	Number of Stages: <u>1</u>

Pump Test Data	Method of Measuring Water Level Circle one
Date Well Tested: _____	Air Line <input type="checkbox"/> Electric Measuring Line <input type="checkbox"/> Steel Tape <input type="checkbox"/>
Static Water Level (A): _____ Feet Below Land Surface	Other (specify): _____
Pumping Water Level (B): _____ Feet Below Land Surface	For flowing well, measured shut in head: _____ feet
Drawdown [(B) - (A)]: <u>NOT TESTED</u> Feet Below Land Surface	Well yielded _____ GPM with a drawdown of _____ feet after _____ hours of pumping
Test Pumping Rate: _____ Gallons Per Minute	
Duration of Pump Test (minimum 4 hours): _____ hours	

This is for (circle one): New Well Replacement of Existing Pump Repair of Existing Pump

I HEREBY CERTIFY that the above statements are true to the best of my knowledge.

Cory Rowe 0-711P
 Print Name of Pump Installer and License No. (if applicable)

[Signature]
 Signature of Pump Installer

RECEIVED


MAY 23 2012

Form: OLWR-SWR-1C (07-09)

BY: OLWR



Internet Mapping Framework

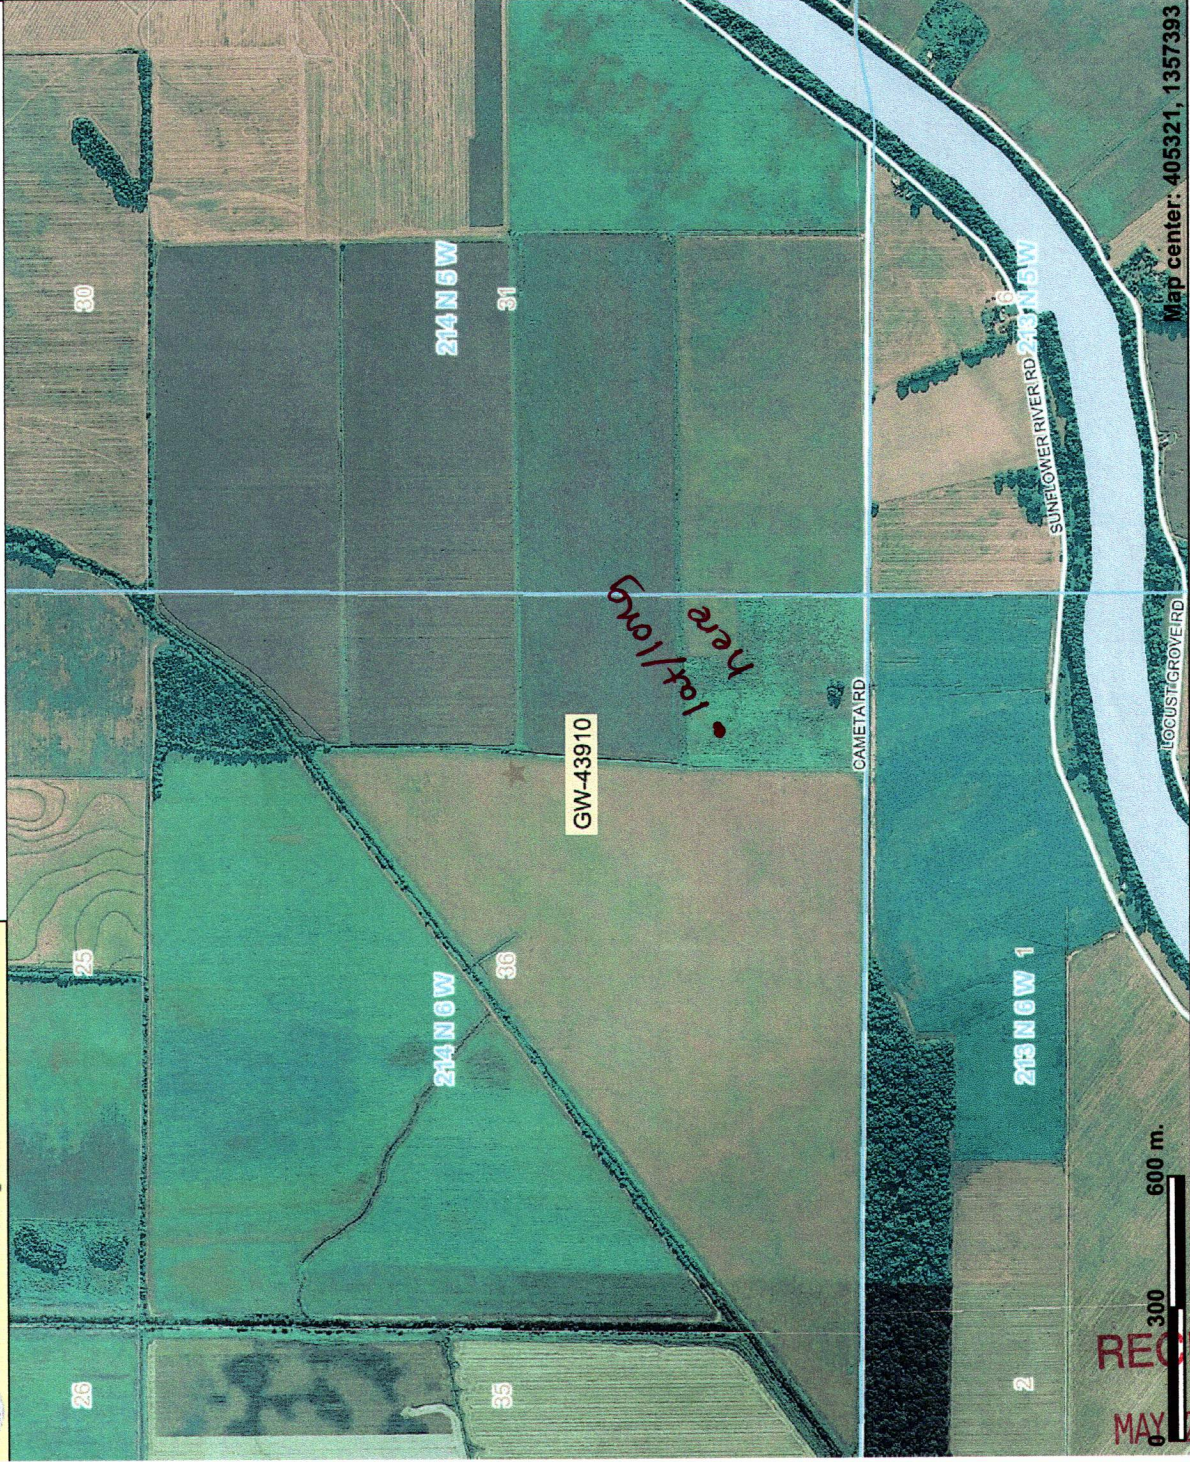

Legend

- County Boundaries
- Township
- Public Land Survey System
- MS One Call Natchez Trace parkway
- MS One Call Interstate Highway
- MS One Call US / State Highway
- MS One Call 3 digit State Highway
- MS One Call County Roads and Streets
- Incorporated Cities
- Other Urban (non-incorporated)
- NHD Other Areas (dbi streams and inun)
- adams07_m.sid
- alcorn07_m.sid
- amite07_m.sid
- attala07_m.sid
- benton07
- bolivar07_m.sid
- calhoun07_m.sid
- carroll07_m.sid
- chickasaw07_m.sid
- choctaw07_m.sid
- clarborne07_m.sid
- clarke07_m.sid

Scale: 1:16,444



RECEIVED
MAY 2012

BY: OLWR

This map is a user generated static output from an Internet mapping site and is for general reference only. Data layers that appear on this map may or may not be accurate, current, or otherwise reliable. THIS MAP IS NOT TO BE USED FOR NAVIGATION.