Sharkey
B 24
6-28-77

MISSISSIPPI
BOARD OF WATER COMMISSIONERS
416 North State Street
Jackson, Mississippi 39201

CODED

WATER WELL DRILLERS LOG

6-28 1977 Dyer Well & Irrigation Sharkey
date well completed — firm name — county well located

LANDOWNER: W. A. Hodnett
Route 1
Anguilla, Miss.
(mailing address)

WELL LOCATION:
sec. 36 T 14 (N) S R 5 E (W)
6 miles NW of Louise
(distance) (direction) (nearest town)

WELL PURPOSE: Irrigation
(home, irrigation, municipal, industrial)

WELL COMPLETION DATA:

(1) diameter (inches) 16"
(2) total depth (feet) 113'
(3) static water level (feet) 35' below above top of ground.
(4) casing Steel (material), 73' (depth), 16" (size) if telescope see back.
(5) screen 40' (length) Steel, 73' (depth to top), 16" (size), Steel (material)
(6) pump 40 (HP) 1800 (yield gpm)
Diesel (type power)
(7) electric log NO (yes or no)
(organization running log)
(8) how well bottom plugged Plate

DRILLERS REMARKS:

description of formations encountered	from	to
Clay	0	30
Fine Sand	30	43
Sand & Gravel	43	113

CODED

RECEIVED
SEP 28 1977
MISS. BD. OF WATER COMMS.

If well telescopes please sketch and show depths.

GROUND LEVEL

16" casing 73' Depth

16" Screen 40' Depth 2 sections 20' EACH

If more than one screen, show locations of each on sketch.

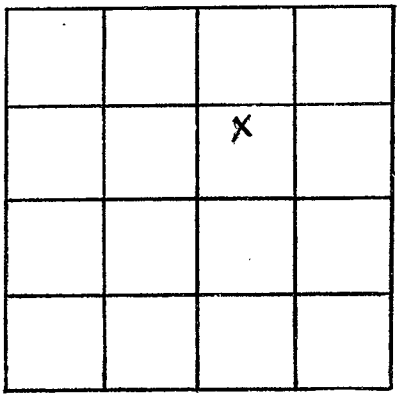

SECTION 36

Please indicate well location X.

ADDITIONAL INFORMATION