County: Sharkey
Permit #: GW-46522
Driller: Clarence McMurray
Date drilling completed: 8-30-13

STATE WELL REPORT
Part 1
Driller's Log

Mississippi Department of Environmental Quality
Office of Land and Water Resources
P.O. Box 2309
Jackson, MS 39225-2309
(601)961-5210
(601)360-0535 (fax)

For Office Use Only:
Well #: B154
Aquifer:
E-Log #:

State Law requires that this report be prepared by the license holder responsible for the work and filed with the Department at the above address within 30 days of completion of drilling of the well or borehole.

Well Owner Information (Landowner if borehole is not for a water well)

Owner Name: JWB MS, LLC
Mailing Address: 4424 Carolina Hwy
Denmark SC 29042
City State Zip Code
Telephone No. (662) 347-8050

Well or Borehole Location

Latitude: 33° 03' 08.08" Longitude: 90° 41' 11.89"
Method of Lat/Long (check one): Conventional Survey ____, USGS quad ____, Hand-held GPS ✓, Survey-grade GPS ____
SW ¼ SW ¼, Sec. 14 T 14N R 05W
6.3 Miles East of Delta City
(Distance) (Direction) (Nearest Town)

Well / Borehole Data

Date drilling started: 8-30-13 Date drilling completed: 8-30-13 Hole depth: 135' Hole diameter: 26"
Location of the source of any surface water used for drilling: Hauled water
Method of dosing and volume of Chlorine used in drilling and development:
Logs run (circle all applicable): No log run Electric Gamma Ray Density Sonic Neutron Other:
Name of organization running log(s):
Purpose of borehole (circle one): Water Well Geotechnical/Geological Investigation Ground Source Heat Pump Seismic Survey Other (describe)

If drilling is not related to water well construction, skip the remainder of this block

Purpose of Well (circle all applicable): Home Industrial Public Supply Irrigation Fish Culture
Other (describe):
If a flowing well, method of flow regulation: Valve ____ Other (describe) N/A
Static Water Level: 22 feet [above or below] land surface (circle one) Date measured: 9-3-13
Method of measurement (circle one): Steel tape Electric tape Air line Other (describe):
Well depth: 135' Well grouted to a depth of: 10 feet Type of grout (circle one): Neat Cement Bentonite Mix
Casing length: 85 feet Casing diameter: 16 inches Type of casing: PVC
Screen length: 50 feet Screen diameter: 16 inches Type of screen: PVC
Screen slot size: .050 inches Setting depth: From 85 feet to 135 feet
Type of completion (circle all applicable): Gravel packed Underreamed Open hole Natural Development
Other (describe):
Top of lap pipe or reduction in casing: N/A feet
If telescoped or more than one screen, describe on next page

RECEIVED
BY LOWR

Form: OLWR-SWR-1A (4/13)

County: Sharkey
Permit #: GW-46522

For Office Use Only:
Well #: B154

The sketch below only required for water wells

If well telescopes, show depths on sketch.

Ground Level

If more than one screen, show location of each on sketch

Description of formations encountered must be provided for all wells and boreholes, unless specifically exempted by regulations

Description of Formations Encountered	From (depth)	To (depth)
Clay	Ground level	28
Fine Sand & Clay	28	37
Fine Sand	37	53
Medium Sand & Gravel	53	68
Fine Sand	68	78
Medium Sand & Gravel	78	87
Medium/Coarse Sand & Gravel	87	98
Medium Sand & Gravel	98	102
Medium/Coarse Sand & Gravel	102	135

Sketch the property layout and include the following:
1) the well location
2) any permanent structures on the property that may aid in locating the well
3) any roads, power lines, or other items that may aid in locating the property and the well
4) north arrow

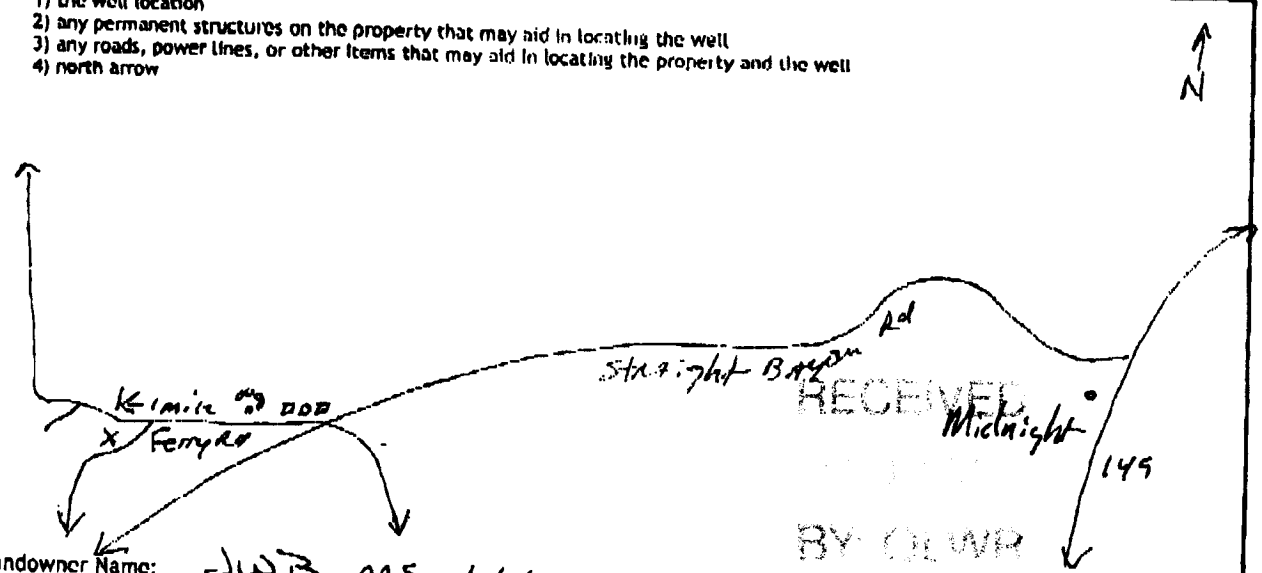

Landowner Name: JWB, MS, LLC

I HEREBY CERTIFY that the well/borehole was drilled, constructed, and completed in accordance with all applicable requirements of the Mississippi Department of Environmental Quality and the Mississippi Department of Health regulations, if applicable, and state laws.

Clayton Miller 0-703 — Print Name of Responsible Licensee and License No.
9-10-13 — Date
Clayton Miller — Signature of Licensee

Form: OLWR-SWR-1A (4/13)

RECEIVED BY OLWR

STATE WELL REPORT

Part 2

Pump Installer's Completion Report

Mississippi Department of Environmental Quality
Office of Land and Water Resources
P.O. Box 2309
Jackson, MS 39225-2309
(601)961-5210
(601) 360-0535 (fax)

County: Sharkey
Permit #: GW-46522
Driller: John Reybolt IV
Date completed: 9-3-13
Copy information from block on Part 1

For Office Use Only:
Well #: B154
Aquifer:

This part of the report must be completed by a licensed water well contractor or a licensed pump installer. A copy of Part 1 of the report must be attached and both parts filed with the Department at the above address within 30 days of well completion.

Well Owner Information

Owner Name: JWB MS LLC
Mailing Address: 4424 Carolina Hwy
Denmark SC 29042
City State Zip Code
Telephone No. (662) 347-8050

Well Location

Latitude: 33° 03' 18.08" Longitude: 90° 41' 11.85"
Method of Lat/Long (check one): Conventional Survey___, USGS quad___, Hand-held GPS ✓, Survey-grade GPS___
SW SE ¼ SW ¼, Sec 14 T 14N R 05W
6.3 Miles East of Delta City
(Distance) (Direction) (Nearest Town)

Pump Type (circle one)

Submersible Turbine Air Lift Centrifugal Flowing Well Jet Piston Rotary Other (describe): ___
Date Pump Installed: 9-3-13 Rated Pump Capacity: ___ Gallons Per Minute
Is This Pump (circle one): New Repaired Replacement

Power Type (circle one)

Electric Diesel Gasoline Natural Gas Tractor PTO Windmill Other (describe): ___
Horse Power Rating of Motor: 30 Setting Depth: 80 feet Number of Stages: 1

Pump Test Data for Non Flowing Well

Date Well Tested: DOT TEST FLOW Duration of Pump Test (minimum 4 hours): N/A hours
Static Water Level (A): 22 Feet Below Land Surface Pumping Water Level (B): N/A Feet Below Land Surface
Drawdown [(B) - (A)]: N/A Feet Below Land Surface Test Pumping Rate: N/A Gallons Per Minute
Method of measurement (circle one): Steel tape Electric tape Air line Other (describe): ___

Pump Test Data for Flowing Well

Measured shut in head: ___ feet.
Well yielded ___ GPM with a drawdown of ___ feet after ___ hours of pumping

Meter Installation

Meter Manufacturer: ___ Meter Serial Number: ___
Meter Model Number/Name: ___ Type of Meter: ___
Totalizer Register Unit and Multiplier Factor (AF x .001, gal x 1000, etc): ___
Installation Date: ___ Meter Installed by: ___
Is This Meter (circle one): New Repaired Replacement

Important: By submitting the above information you are certifying that this meter was installed to manufacturer standards. For agricultural wells, a list of approved meters is on the MDEQ website.

I HEREBY CERTIFY that the above statements are true to the best of my knowledge.

Clayton Miller 0-703 — Print Name of Pump Installer and License No. (if applicable)
9-10-13 — Date
Clayton Miller — Signature of Pump Installer

Form: OLWR-SWR-1B (4/13)