CODED

MISSISSIPPI DEPARTMENT OF NATURAL RESOURCES

Bureau of Land and Water Resources

P.O. Box 10631
Jackson, Mississippi 39209

WATER WELL DRILLERS LOG

COUNTY WELL LOCATED: Sharkey	
WELL NUMBER: F21	CODED
DATE WELL COMPLETED: 8-11-88	
PERMIT NUMBER: MS-GW- 11011	
NAME OF DRILLING FIRM: Dyer Well	

NAME & MAILING ADDRESS OF LANDOWNER
Carter Bros
Box 458
Rolling Fork, Ms.

WELL LOCATION: SEC 18 TOWNSHIP 12 (N) S RANGE 6 (E) W

DISTANCE 3 Miles DIRECTION SE NEAREST TOWN Rolling Fork

OTHER LANDMARK

WELL PURPOSE: Home, Irrigation, Municipal, Industrial, Fish Pond, etc.

PUMP DATA

PUMP TYPE (Circle One): Submersible, Turbine, Jet Flowing Well, Other (Describe)

POWER TYPE (Circle One): Electric, Tractor, Diesel, Gasoline, Butane, Other (Describe)

Pump Capacity (GPM)	No. of Stages	Setting Depth
1500	2	60 FT.

PUMP TEST

Well yielded _____ GPM with a drawdown of _____ ft. after _____ hours of pumping

WELL DATA

Well Depth	Casing Diameter (In.)	Casing Length (Ft.)
120	16	80

Type of Casing	Hole Depth	Depth to Static Water Level
Steel		

TYPE OF COMPLETION: (Circle One or More): Gravel Packed, Underreamed, Telescoped, Natural Development, Open Hole, Other (Describe)

Top of Lap Pipe or Reduction in Casing FEET

IF TELESCOPED OR MORE THAN ONE SCREEN: USE BACK PAGE

LOG DATA

TYPE OF LOG RUN (Circle One): No Log Run, Electric, Gamma Ray, Density, Sonic, Neutron, Other (Describe)

Name of Organization Running Log: None

GEOLOGIC DATA (Office Use Only)

Surface Elev.	Geologic Unit	Unit Thickness	Depth to Top
Subs. SWL	Date	Analysis	Aquifer Test

Driller's Remarks

SCREEN DATA

Diameter - Inches	Length - Feet	Slot Size - Inches
16"	40	.030

Screen Type	Depth to Bottom - Feet
Johnson-Wire	

DESCRIPTION OF FORMATIONS ENCOUNTERED	FROM	TO
Clay	0	42
Fine Sand	42	70
Fine Sand + Gravel	70	98
M Sand + Gravel	98	120

FORMATIONS (Continued)	FROM	TO

RECEIVED
SEP 19 1988
Department of Natural Resources
Bureau of Land & Water Resources

IF MORE SPACE IS NEEDED, USE BACK

If well telescopes please
sketch and show depths.

GROUND LEVEL

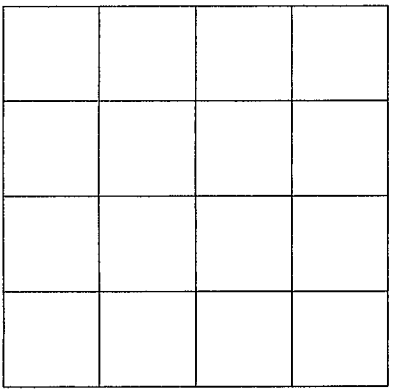

SECTION _____

Please indicate well location X.

ADDITIONAL INFORMATION

If more than one screen,
show location of each on sketch.