

SHARKEY MISSISSIPPI BOARD OF WATER COMMISSIONERS

617
6-5-63

WATER WELL DRILLERS LOG

Date: 6-5-63 19___, Driller: David Beatty Cou. CODED
(Name)

- (1) Owner of Land: Bill Klaus
(Name)
Cany, Miss.
(Address)
- (2) Location: 1/4, 1/4, Sec. 17 T. 11 R. 1
Evans Plantation
_____ miles _____ of _____
(distance) (direction) (Nearest Town)
- (3) Topography: Flat
(Hilly) (Flat) (Level)
- (4) Purpose of Well: Domestic
(Domestic Irrigation
Municipal, Industrial, Other)

Description & Color of Materials Sand, Clay, Red Clay, Shell, etc.	Thick- ness Feet	Depth Feet
Clay		35
Coarse sand	45	80
Coarse sand & gravel	110	190
Hard clay	10	200
Hard sand	235	435
Sandy shell	10	445
Clay	20	465
Rocky & sandy shell	75	540
Mummy shell	40	580
Sandy shell	100	680
Hard Part sand	40	720
Hard clay	60	780
Hard Part. sand	86	866

Information upon completion of well:


- (1) Diameter 4 1/2 inches.
- (2) Total Depth 866 feet.
- (3) Water Level 9' feet below top of ground.
- (4) Cased to 251, Size 4"
- (5) Screen: Size 2", Length 42'
010
- (6) Were any formations sealed against pollution?
_____ yes, _____ no.

If YES depth of formation _____

Why _____

Drillers Remarks: _____

CODED

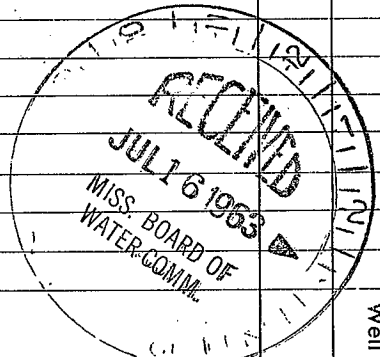

(Use Back Side)

Well No.

100











